


# T. 27 & 28 S., R. 6 W., W.M.

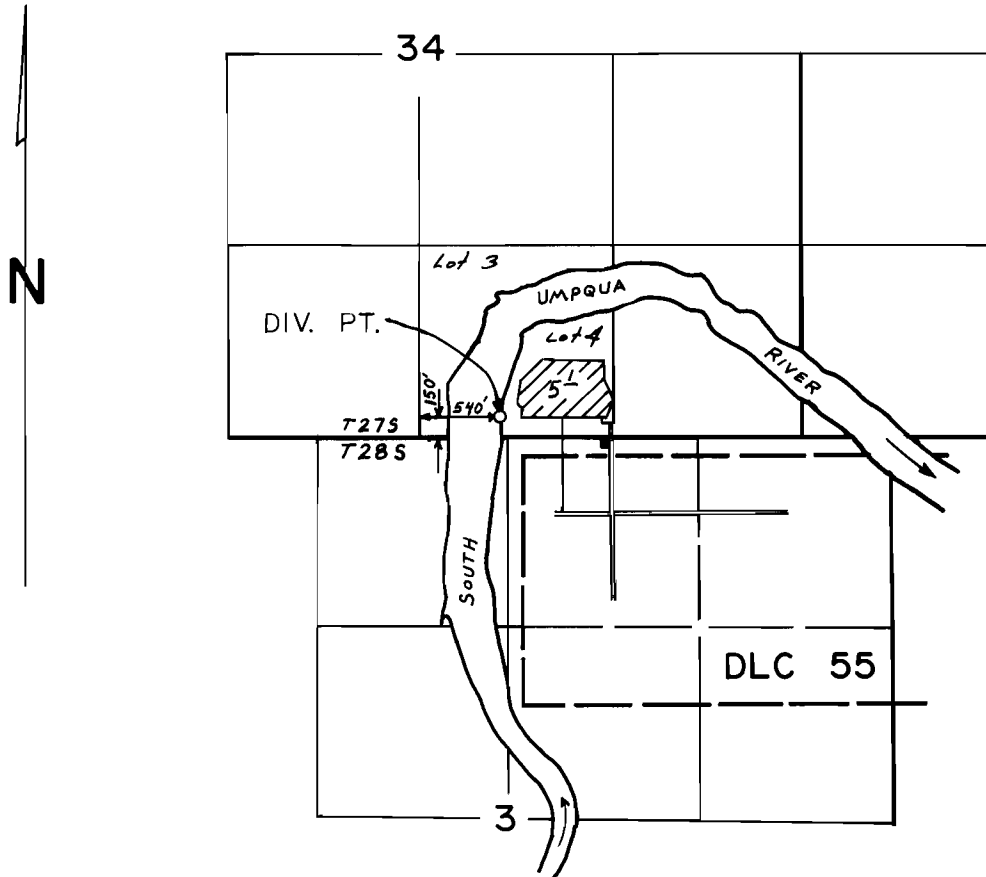

SCALE : 4" = 1 mile

## FINAL PROOF SURVEY UNDER

Application No. 64.601. Permit No. 47341.....  
IN NAME OF

.....GERALD J. GOUDE.....

Surveyed DEC.....7, 1983, by *J.E. Cashion*.....