
90884

T. 22 & 23 S., R. 4 W., W. M.

SECTIONS 31 AND 6

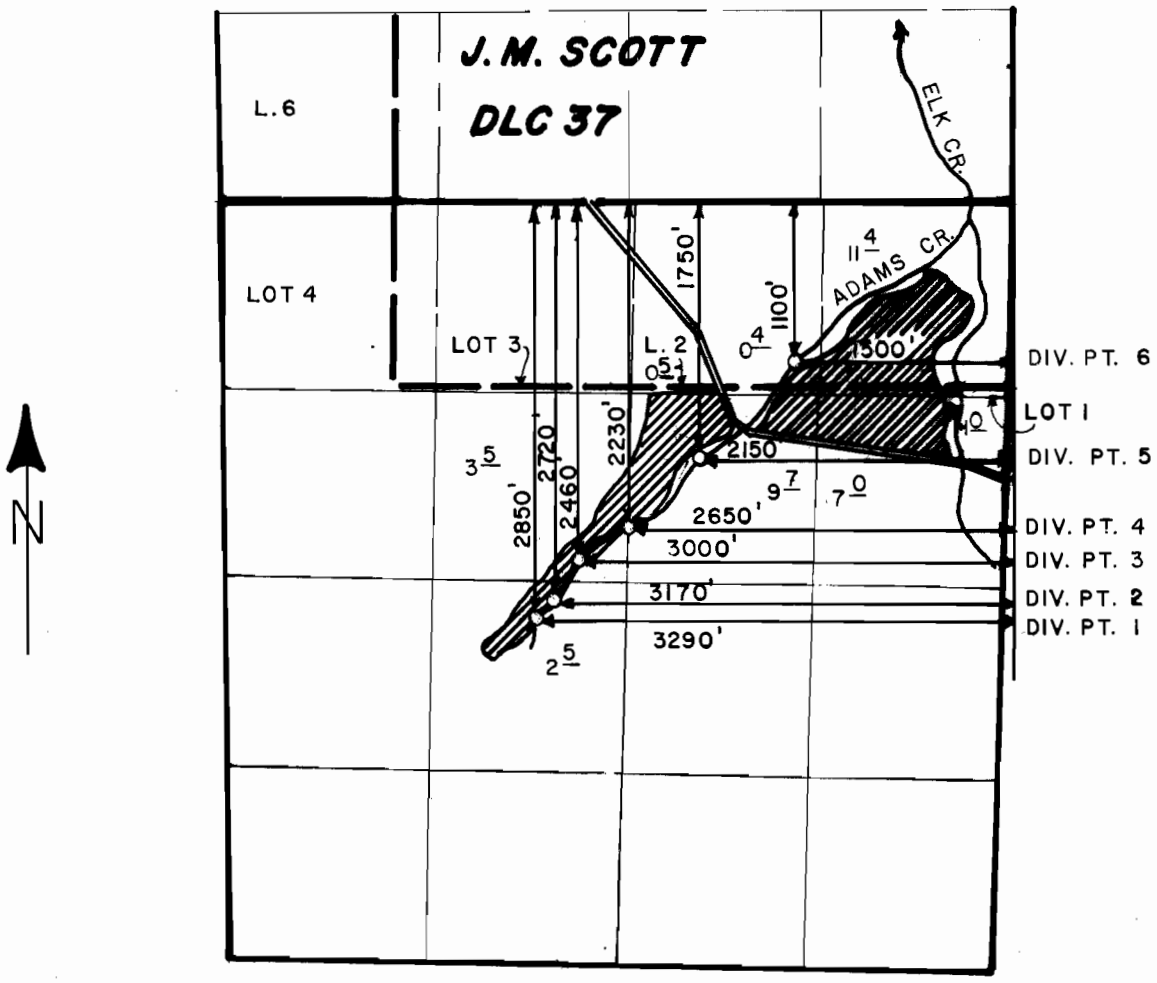

SCALE 4 = 1 MILE

FINAL PROOF SURVEY

UNDER

Application No. 65166 Permit No. 47836

IN NAME OF

HAROLD R. AND MARJORIE BOUCOCK

Surveyed AUG. 11 1988, by J. M. SCHMORDE

41019-378-273L / ZOOM jk