


T. 25 S., R. 13 W., W.M.

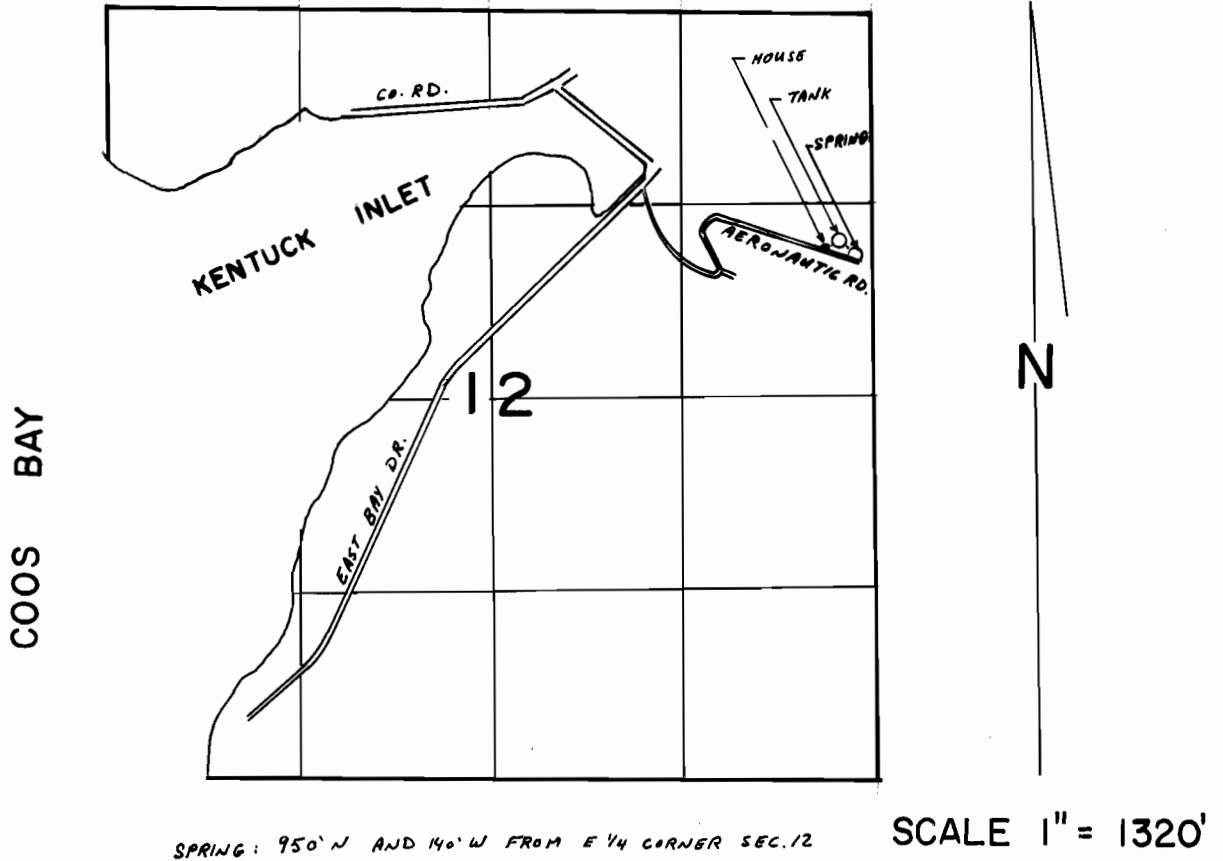

FINAL PROOF SURVEY
UNDER

Application No. **65225** Permit No. **47878**
IN NAME OF

HARRY C. MAY

Surveyed **JUN. 24. 1987.** by **M. SCHMORDE**

41011-180-189 R
6-1-89 z.f.s.