




T. 22 & 23 S., R. 12 W., W.M.

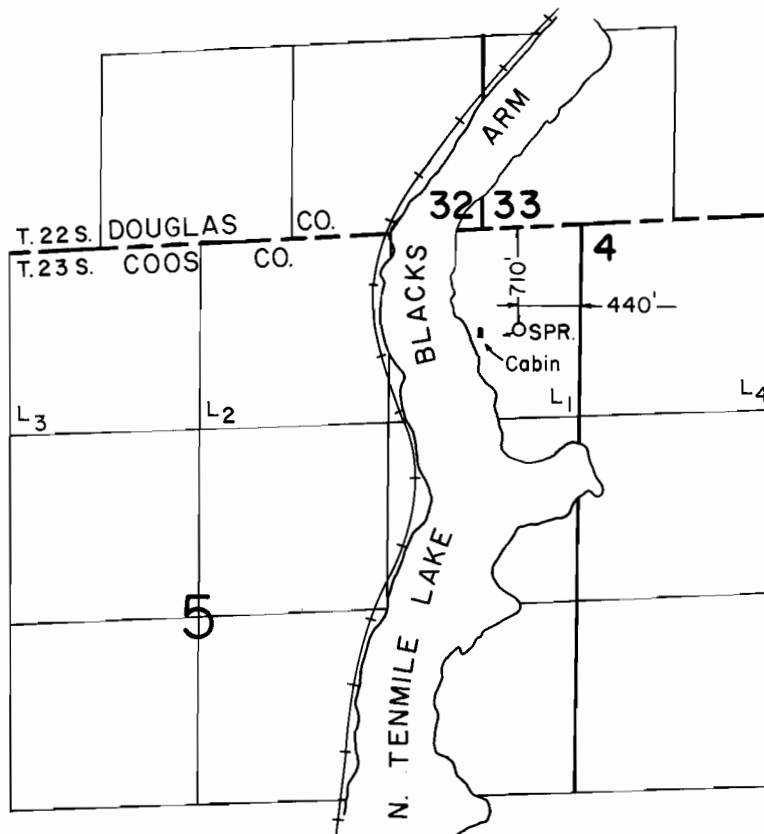

SCALE: 1" = 1320'

FINAL PROOF SURVEY UNDER

Application No. 65567.. Permit No. 47992.....
IN NAME OF

ROBERT & SALLY BLANCHE

Surveyed SEPT. 21. 1988, by T. M. WARREN.