


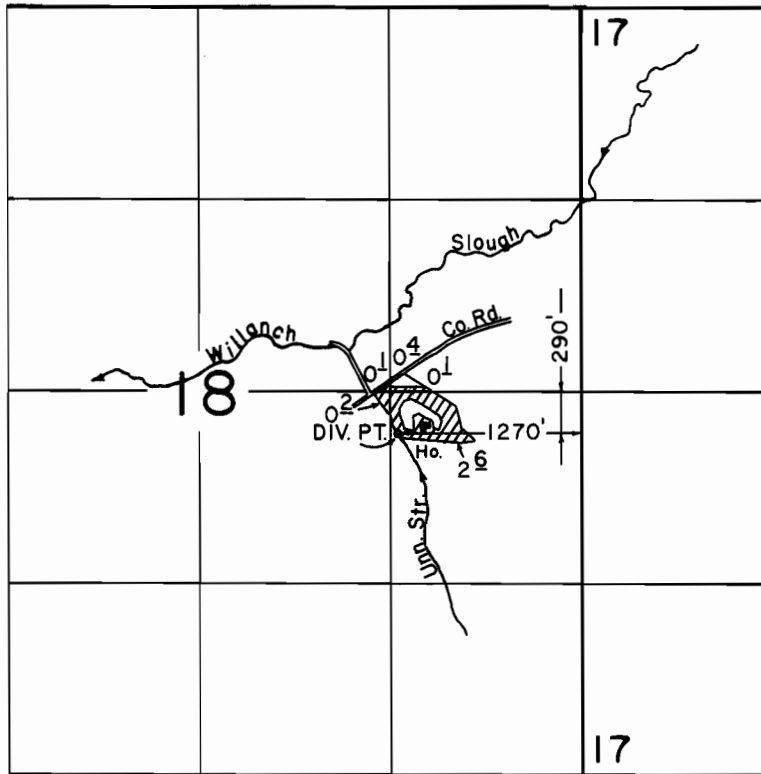

T. 25 S., R. 12 W., W.M.



SCALE: 1" = 1320'

**FINAL PROOF SURVEY**  
UNDER

Application No. 68236 Permit No. 49150  
IN NAME OF

DALE M. & LEONA M. GIFFORD

Surveyed JUNE 24 1987, by M. SCHMORDE