
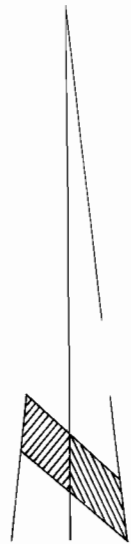


T. 1N., R. 26E., W. M.

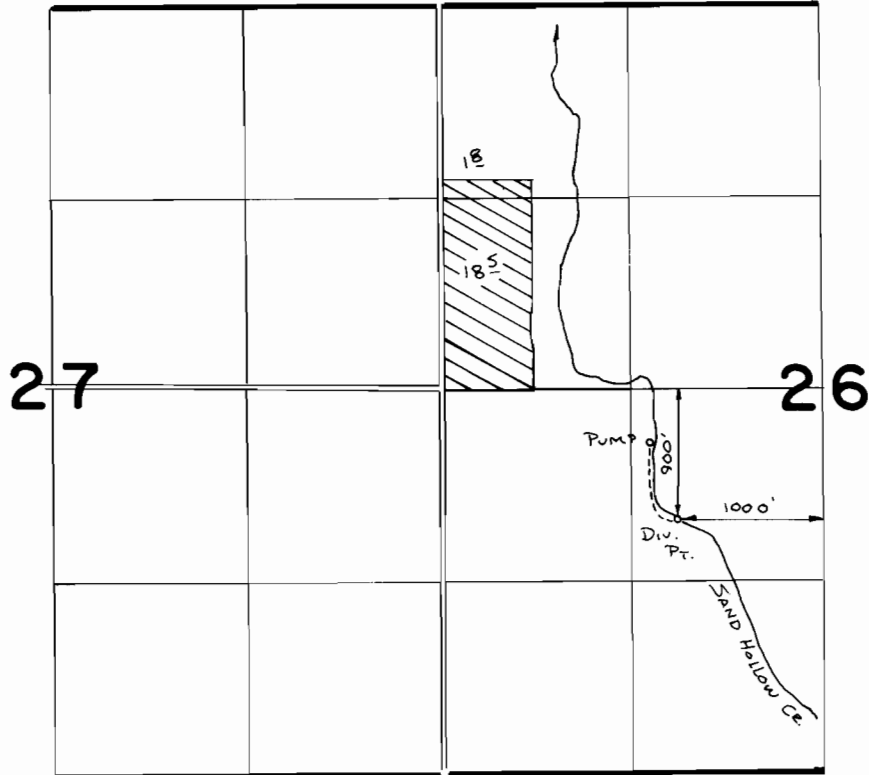

SCALE 1" = 1320'

FINAL PROOF SURVEY
UNDER

Application No. **68251**. Permit No. **49228**..
IN NAME OF

.....**TURNER RANCH, INC.**.....

Surveyed ..1-9..... 1987., by ..V. h. Church.....