




T.23S.,R.12&13W.,W.M.

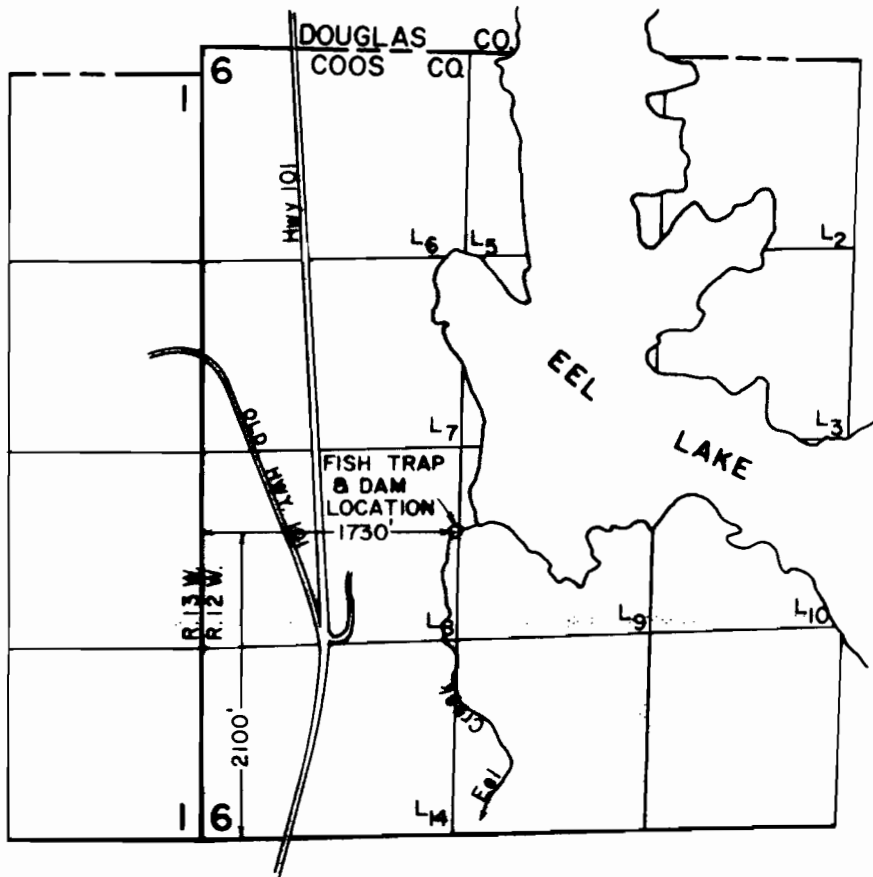

SCALE: 1" = 1320'

**FINAL PROOF SURVEY**  
UNDER

R-68443                      R-10606  
Application No. ~~68444~~ Permit No. ~~49610~~.....  
IN NAME OF

OREGON DEPARTMENT OF FISH & WILDLIFE

Surveyed SEPT. 20 1988, by T. M. WARREN.....