


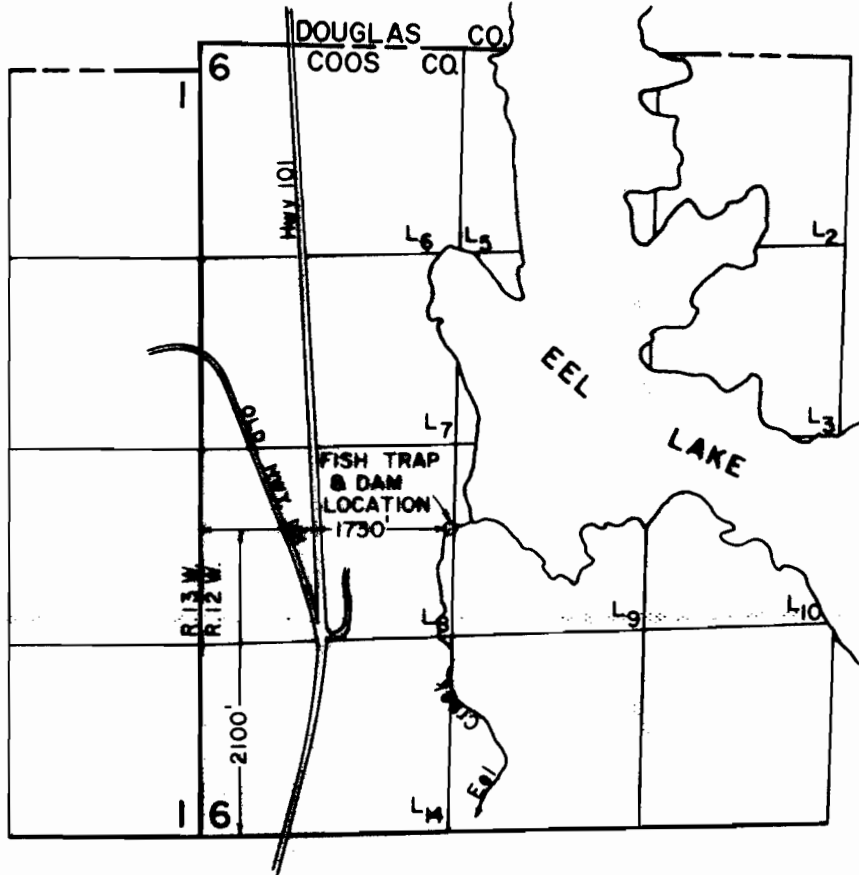

T. 23 S., R. 12 & 13 W., W.M.



SCALE: 1" = 1320'

**FINAL PROOF SURVEY**  
UNDER

R-68443                      R-10606  
Application No. 68444 Permit No. 49610.....  
IN NAME OF

OREGON DEPARTMENT OF FISH & WILDLIFE

Surveyed SEPT. 20 1988, by T. M. WARREN...