


RECEIVED

DEC 6 1985

WATER RESOURCES DEPT
SALEM, OREGON

307-1095
WATER RESOURCES
DIVISION

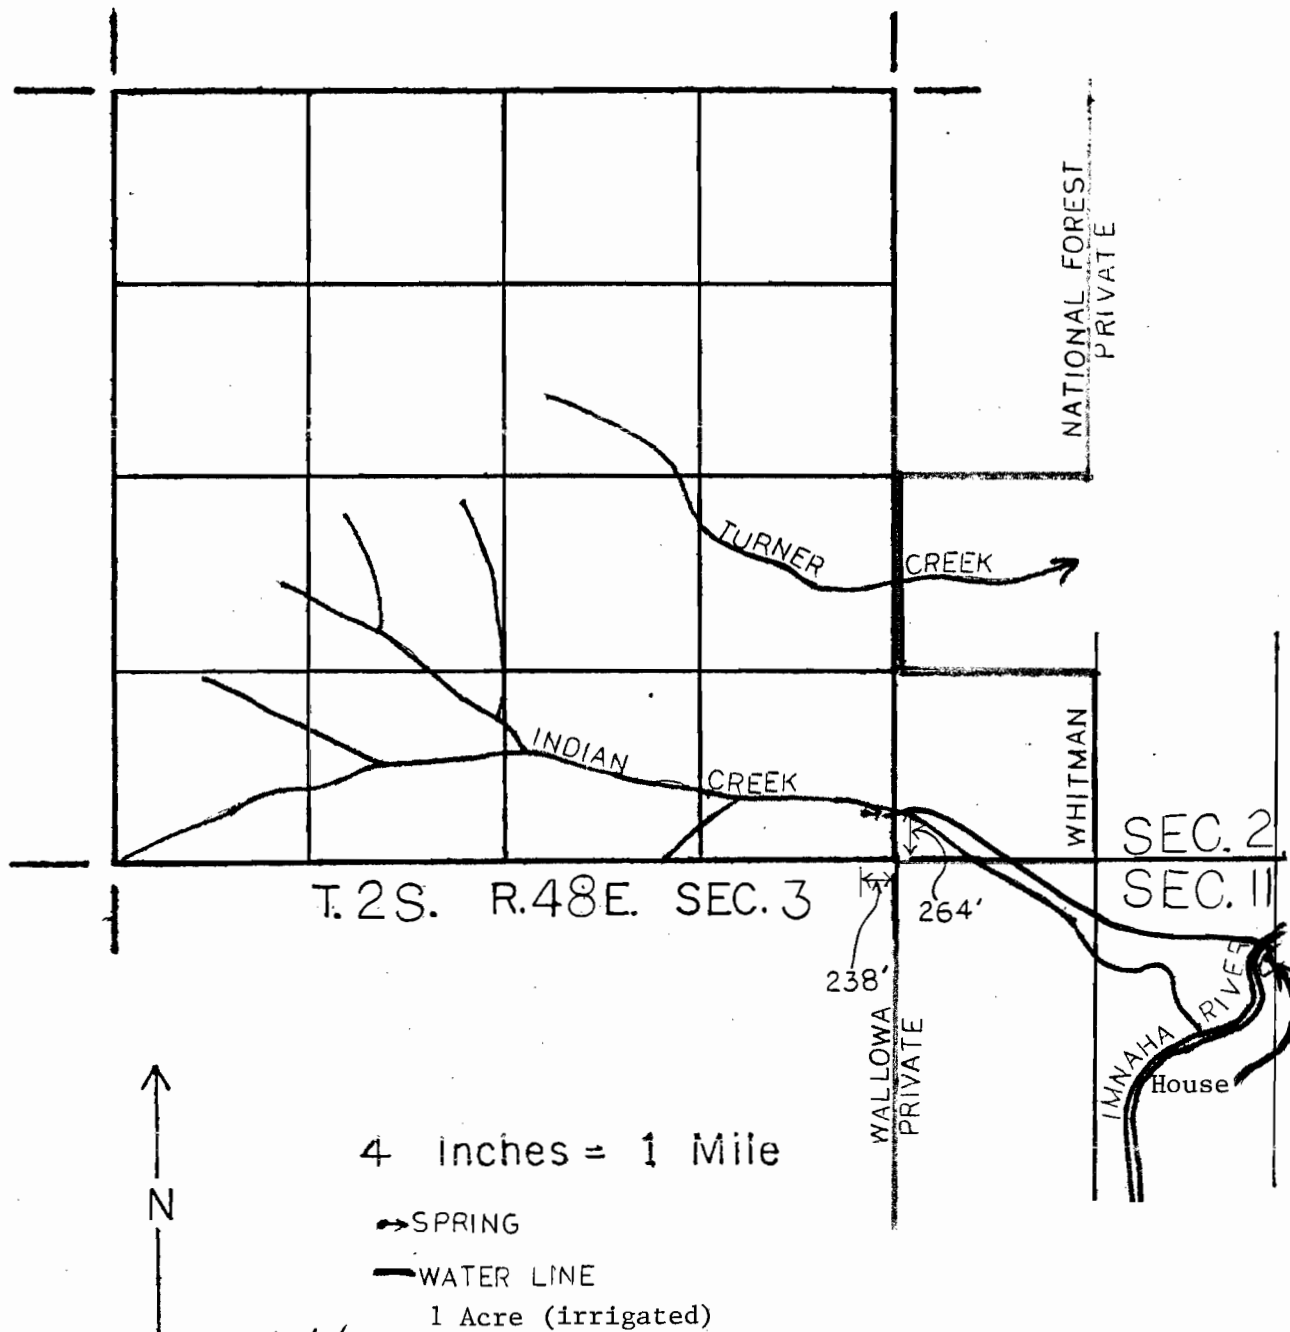

Application No. 68611
Permit No. 49615

Prepared By Ronald E. Boron 7/2/85
UPDATED Ronald E. Boron 12/4/85
UPDATED Ronald E. Boron 4/6/86