




T. 6 S., R. 7 W., W.M.

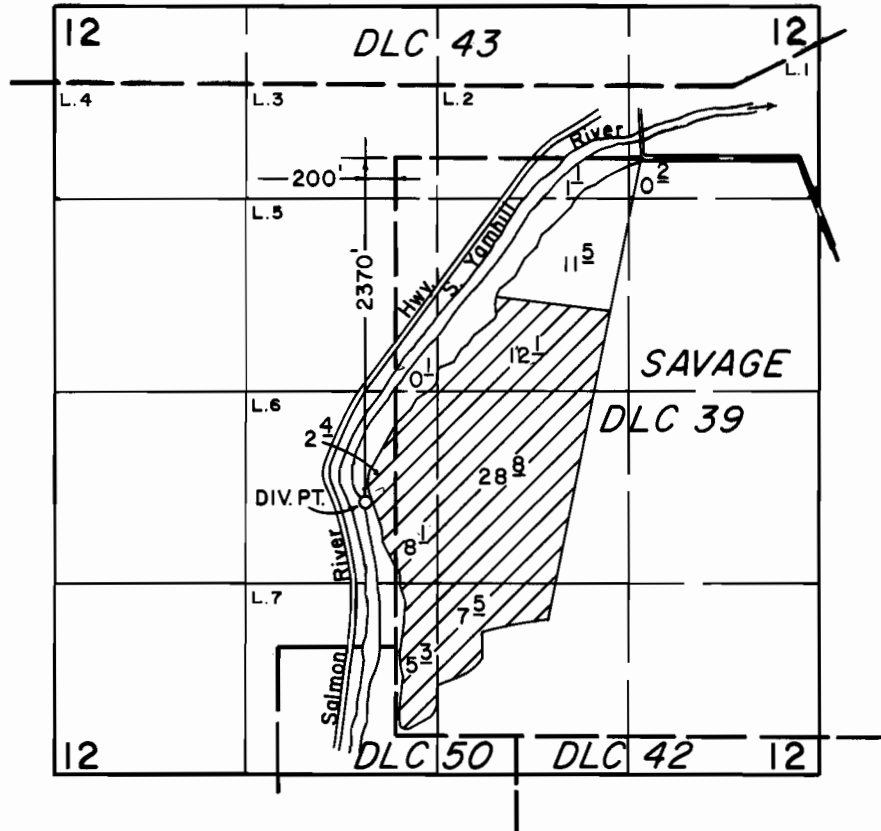

SCALE: 1" = 1320'

FINAL PROOF SURVEY
UNDER

Application No. 68726.. Permit No. 49703.....
IN NAME OF

JOHN A. HEBERT, SR. & NORMA C. HEBERT

Surveyed JUNE 29 1987., by B. W. BISHOP.....