


T. 19 S., R. 12 W., W.M.

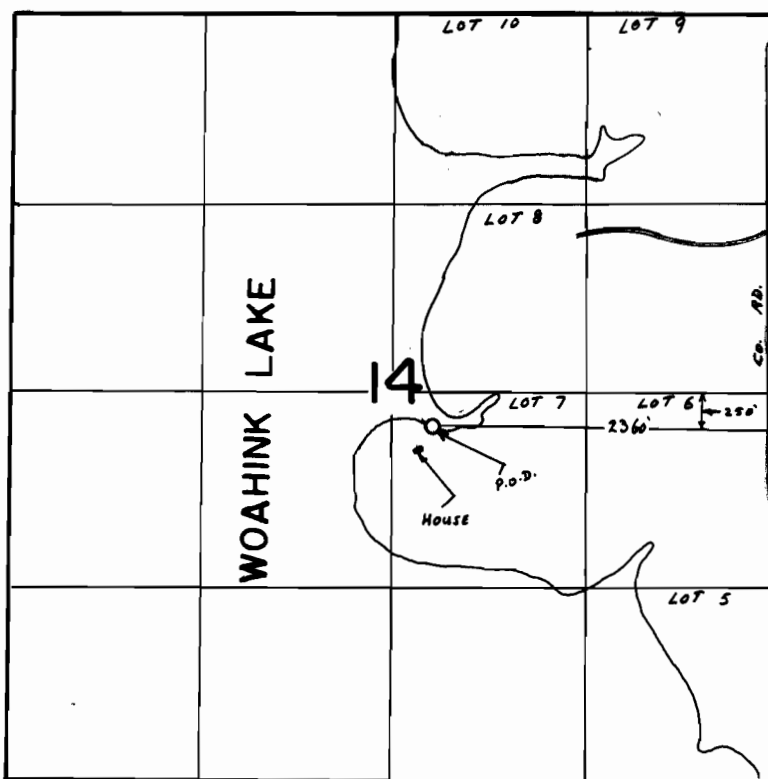

SCALE 1" = 1320'

FINAL PROOF SURVEY
UNDER

Application No. 68733 Permit No. 49706
IN NAME OF

JANE SCHROEDER

Surveyed SEP. 27, 19.88, by ZEIDAN SALEH

41039-128-122L
4-26-89 J.F.S.