


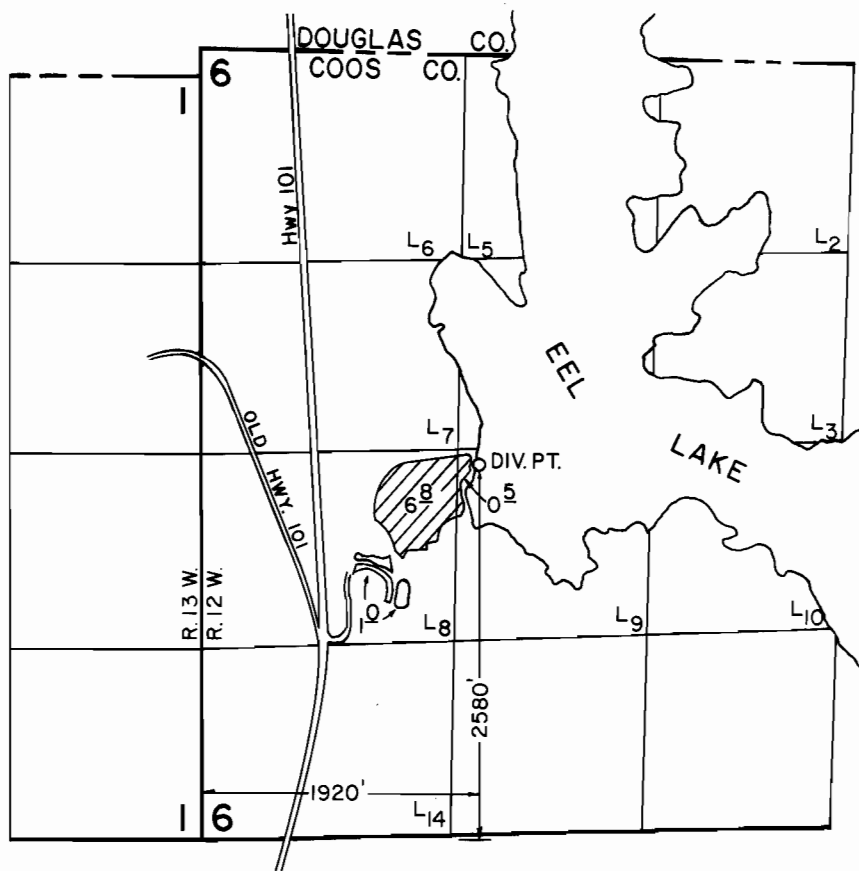

T. 23 S., R. 12 & 13 W., W.M.



SCALE: 1" = 1320'

FINAL PROOF SURVEY
UNDER

Application No. 68820 Permit No. 49861.....
IN NAME OF

OREGON STATE PARKS & RECREATION DIVISION

Surveyed SEPT. 20 1988, by T. M. WARREN.....