




T. 8 S., R. 4 W., W.M.

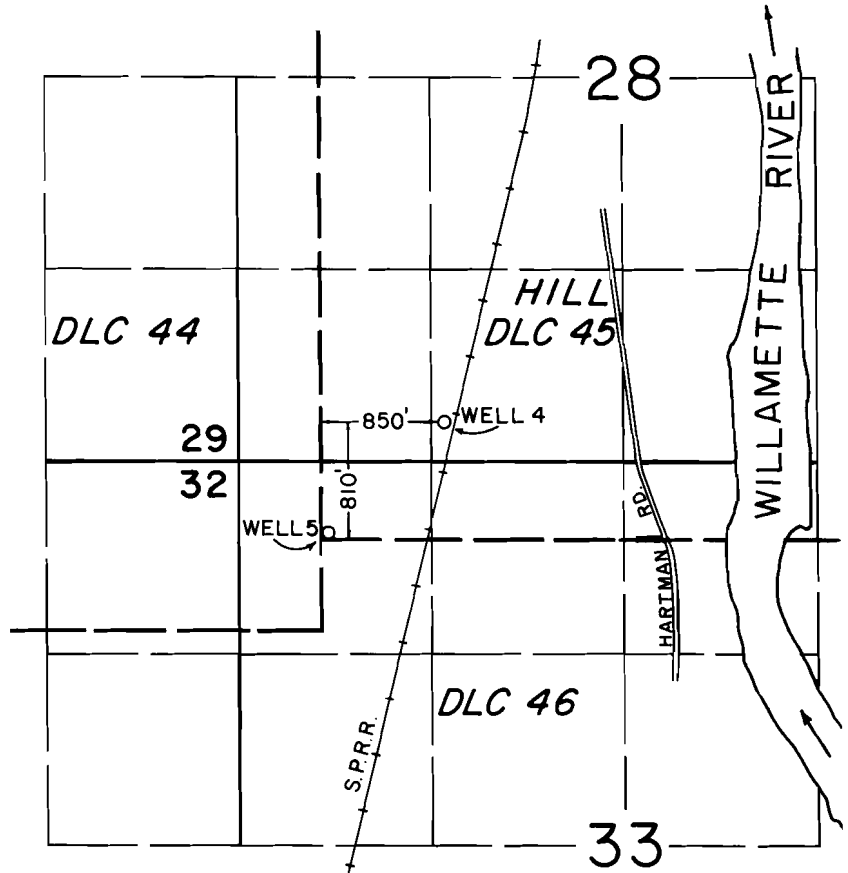

WELL 5 LOC.: 50' N & 50' E. FROM MOST SOUTHERLY S.W. CORNER
DLC 45.

SCALE: 1" = 1320'

FINAL PROOF SURVEY
UNDER

Application No. G-5106 Permit No. G-4818.....
IN NAME OF

CITY OF MONMOUTH.....

Surveyed MAY 12..... 1987., by B. W. BISHOP.....