


T. 5 S., R. 4 W., W. M.

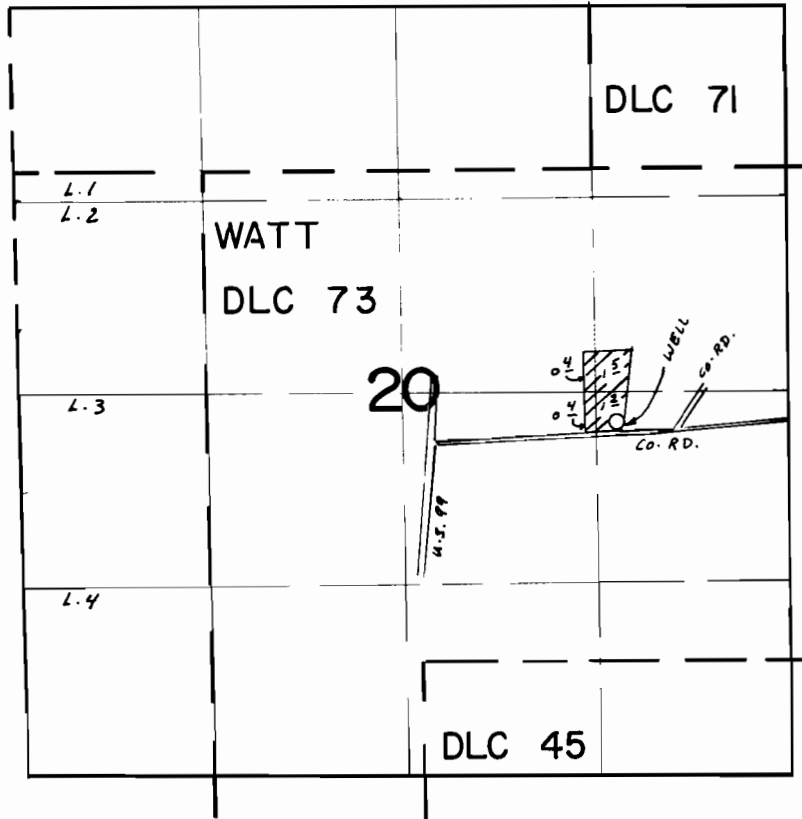

SCALE 1" = 1320'

WELL : 230' S AND 1970' E FROM CENTER SEC. 20

FINAL PROOF SURVEY UNDER

Application No. G-7143 Permit No. G-6593.....
IN NAME OF

JASON & BERTHA M. LEE.....

Surveyed JUL 9 1987, by B. BISHOP.....

41071-178-71D
5-26-89 z.f.s.