




T.9S.,R.2W.,W.M.

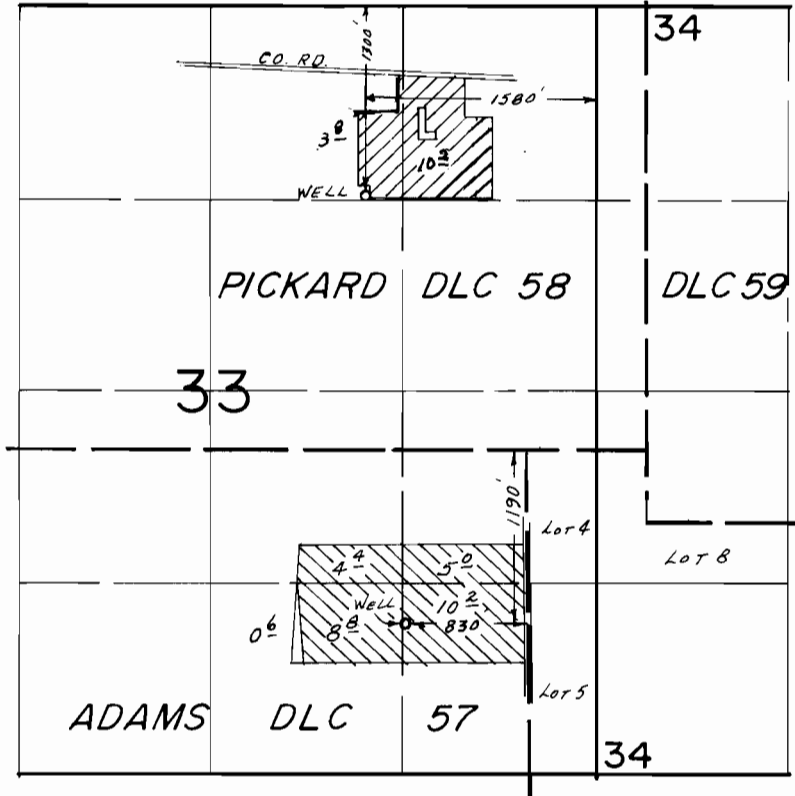

SCALE: 1"=1320'

-  G-7768
-  G-10875

FINAL PROOF SURVEY UNDER

G-7768 G-8533
 Application No. G-10875 Permit No. G-10014...
 IN NAME OF

.....WILLIAM C. GRENZ.....

Surveyed April.23.. 19.85., by .P.R..PAGTER.....