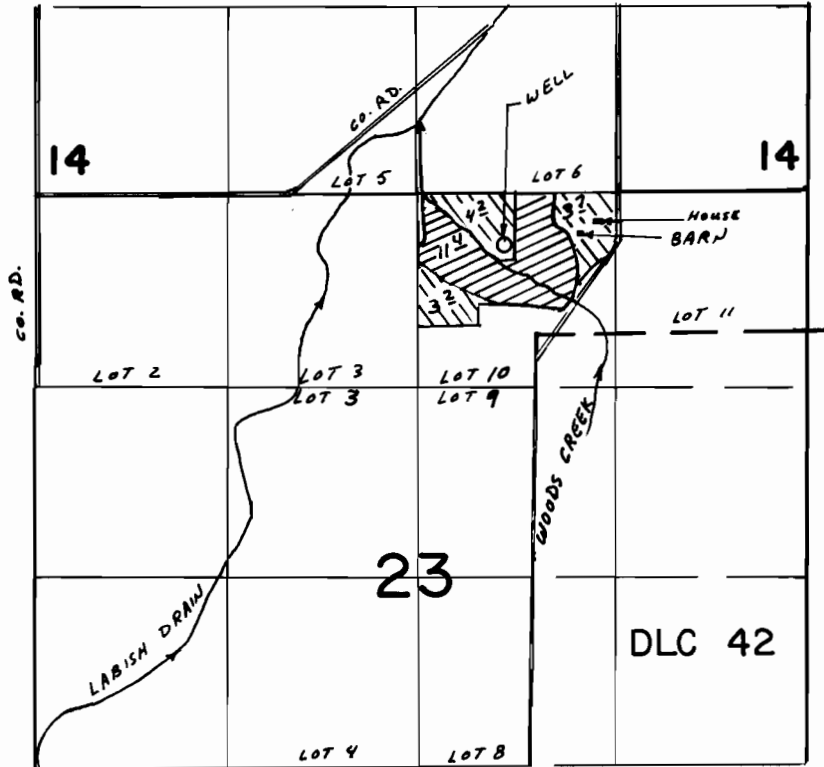

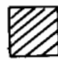


T. 6 S., R. 2 W., W.M.



WELL : 600' N AND 200' W FROM NW CORNER OF DLC 42

-  PRIMARY
-  SUPPLEMENTAL

SCALE 1" = 1320'

FINAL PROOF SURVEY UNDER

Application No. **G-8083** Permit No. **G-7477**
IN NAME OF

WILLIAM T. BROWN

Surveyed **JUN 2** 19**88** by **Z. SALEH**

41047-128-124L
5-24-89 Z.J.S.