


T.5S., R.4 W., W.M.

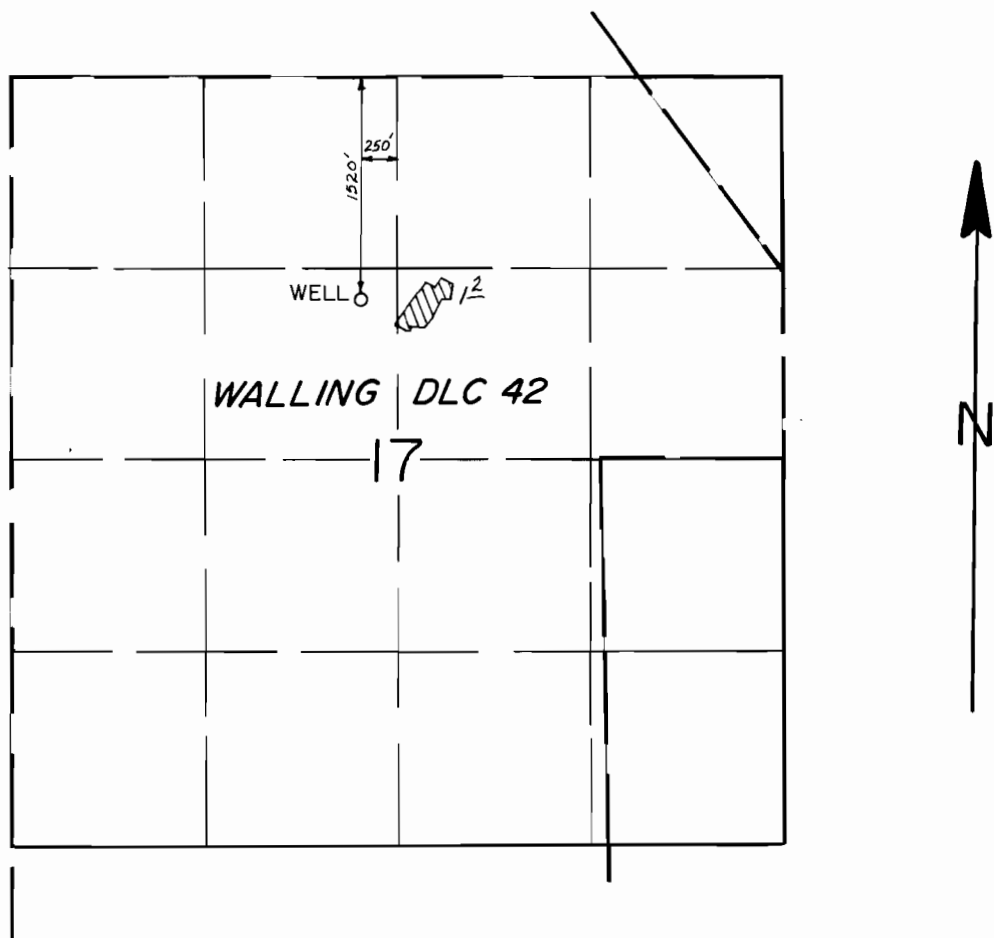

SCALE: 1" = 1320'

FINAL PROOF SURVEY UNDER

Application No. G-8190 Permit No. G-9681
IN NAME OF

MID-VALLEY WORKSHOP AND REHABILITATION CENTERS, INC.

Surveyed SEPT. 4 1985, by B.W. BISHOP