




T. 2 S., R. 3 E., W.M.

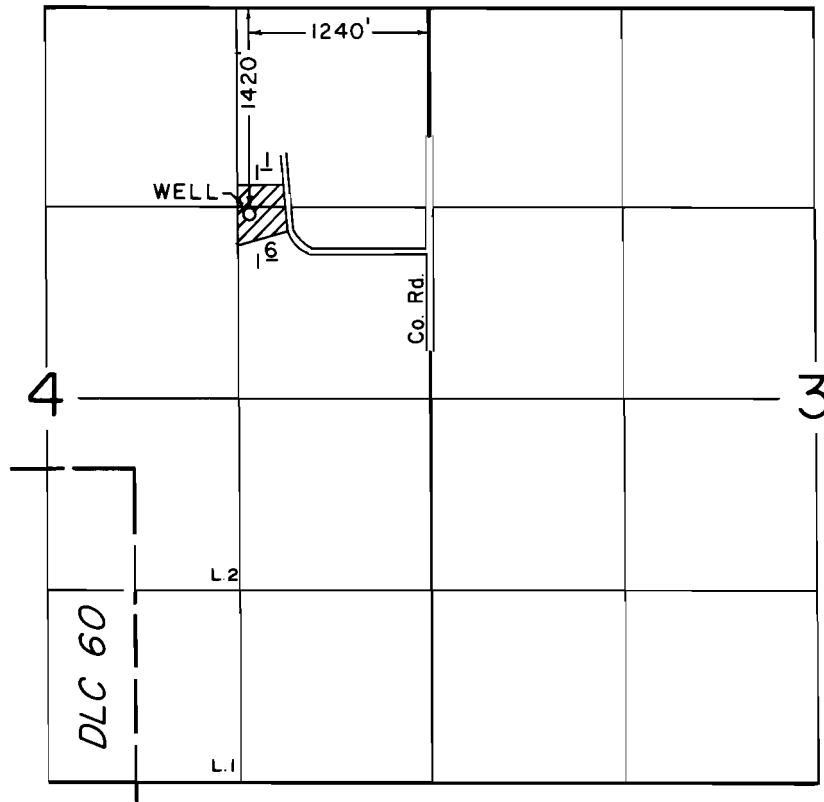

SCALE: 1" = 1320'

FINAL PROOF SURVEY
UNDER

Application No. G-837!.. Permit No. G-77!6.....
IN NAME OF

.....EUGENE MUSKOPF.....

Surveyed MARCH 19 1980., by R. G. MUCKEN.....
AUG. 29 1986 by T. M. WARREN