


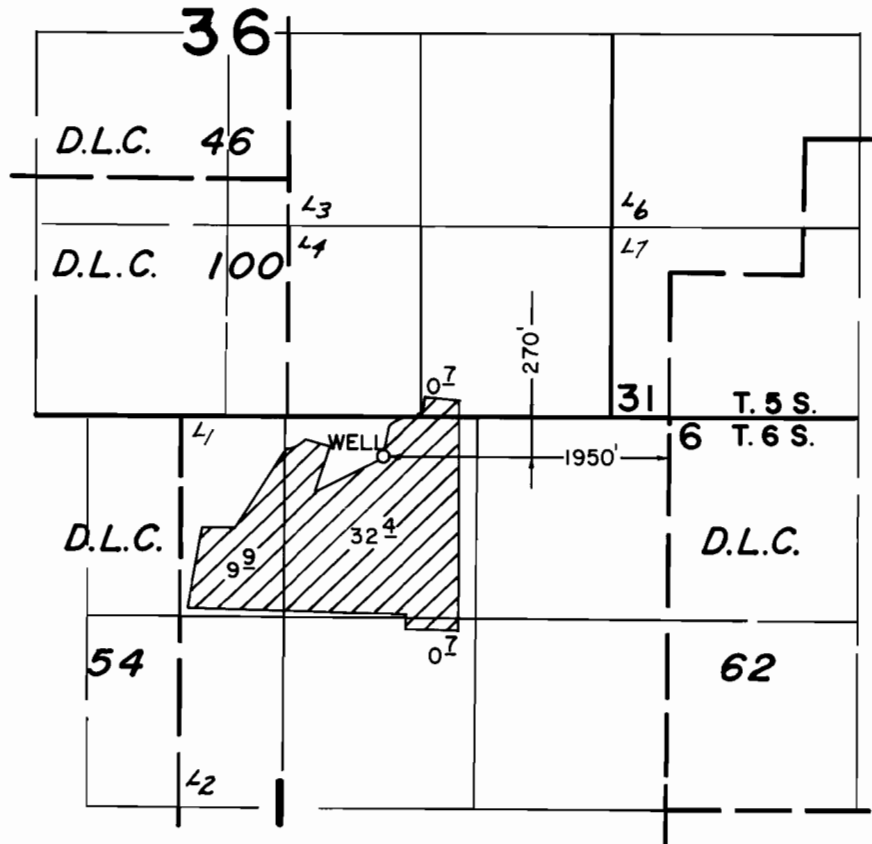

T. 5&6S. R.2W. W.M.



SCALE: 1" = 1320'

FINAL PROOF SURVEY
UNDER

Application No. G-8710 Permit No. G-8022
IN NAME OF

ALBERT J. PRANTL

Surveyed Oct. 4, 1979, by C.R. RODRIGUEZ

Revised: 3-23-87
7-7-89

DFN-6LL-199