


# T. 8S., R. 4W., W.M.

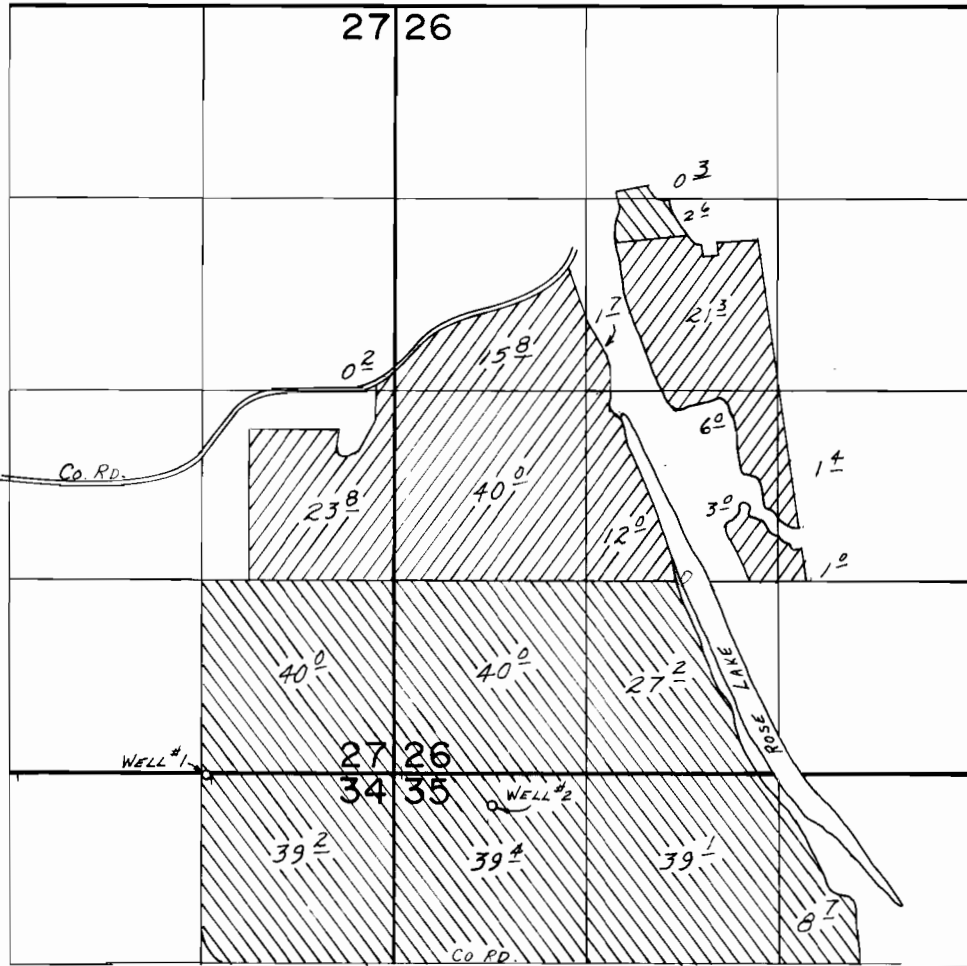

WELLS LOC.: #1- 103 S & 1290 W., #2- 220 S. & 670 E., BOTH FROM NW COR. SEC. 35



PRIMARY  
SUPPLEMENTAL

SCALE: 1" = 1320'

## FINAL PROOF SURVEY UNDER

Application No. G-8927. Permit No. G-8319.....  
IN NAME OF

PETER DINSDALE.....

Surveyed May 3, 1984, by B.W. BISHOP.....