


T. 8 S., R. 4 W., W.M.

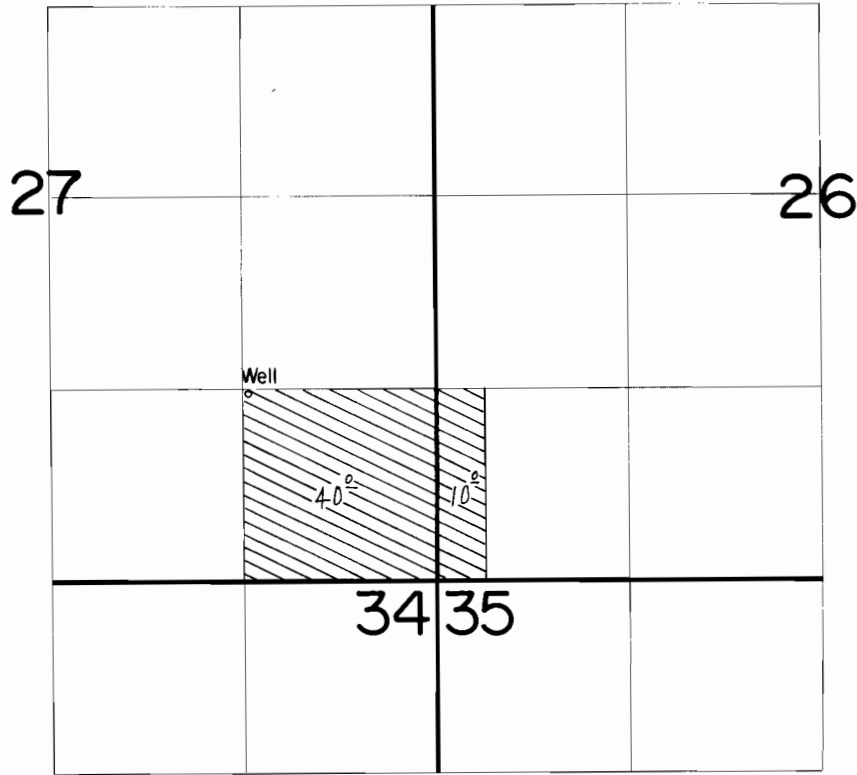

Well Loc. : 1300' N. & 1290' W. from SE Cor. Sec. 27.

Scale: 1" = 1320'

FINAL PROOF SURVEY UNDER

Application No. G-11459.. Permit No. G-10565....

IN NAME OF

PETER B. DINSDALE

Surveyed April..30. 1986., by T. Warren.....