


# T. 8S., R. 4W., W.M.

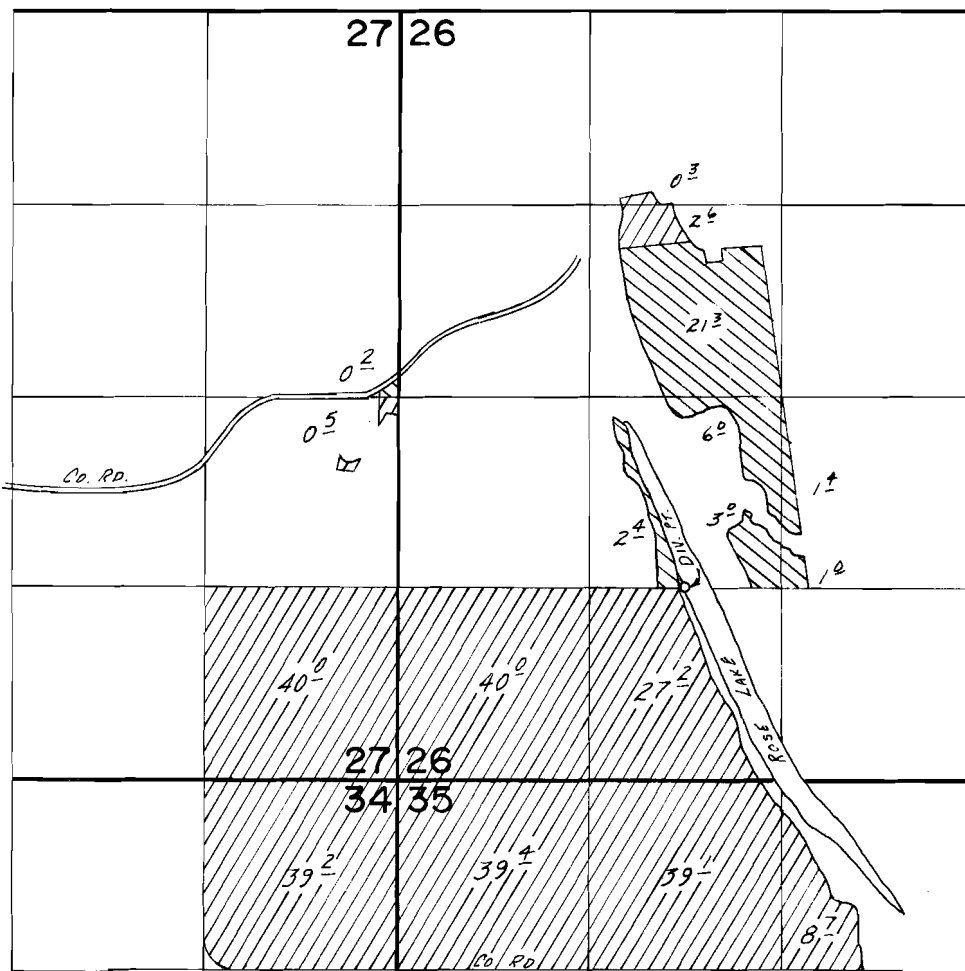

Div. Pt. Loc.: 1340 N. & 1970 E. FROM SW COR. SEC. 26.



PRIMARY  
SUPPLEMENTAL

SCALE: 1" = 1320'

## FINAL PROOF SURVEY UNDER

Application No. 57795.. Permit No. 43572.....  
IN NAME OF

.....PETER DINSDALE.....

Surveyed May 3..... 19.84, by B.W. BISHOP.....

BWB