


T. 25 S., R. 12 W., W.M.

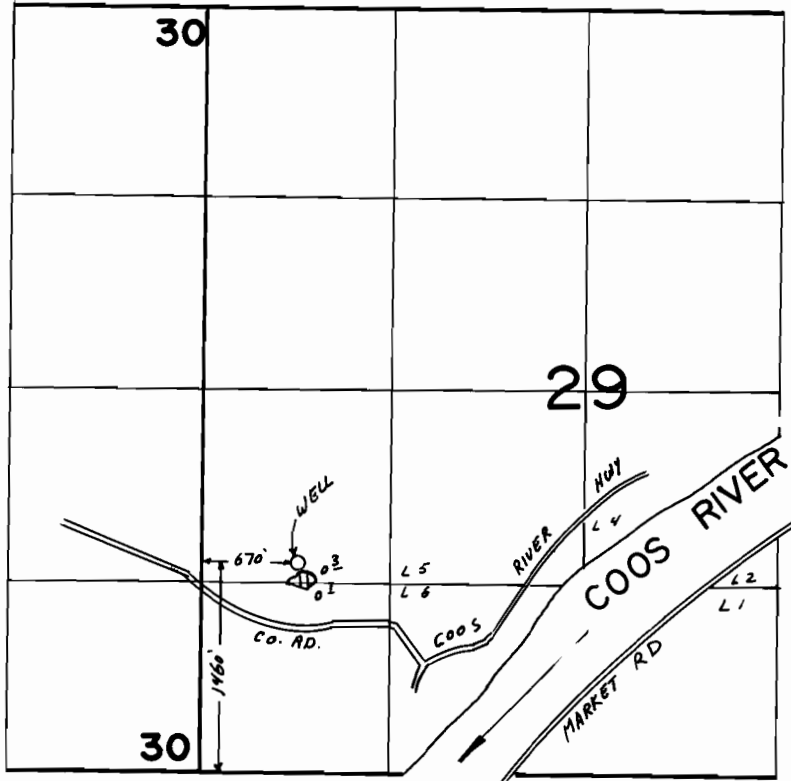

SCALE 1" = 1320'

FINAL PROOF SURVEY
UNDER

Application No. **G-8929** Permit No. **G-8337**
IN NAME OF

LOUDEN H. LOCKHART

Surveyed **JUN 23** 19**87**, by **M. SCHMORDE**

41911-180-236 D
6-20-89 Z.f.S.