


T. 35 S., R. 4 W., W. M.

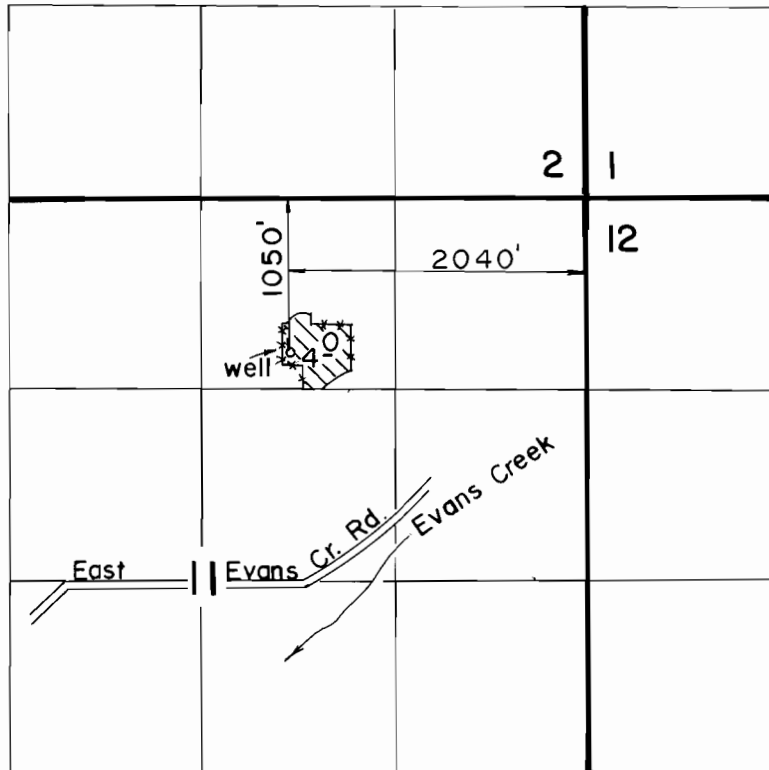

Scale: 1" = 1320'

FINAL PROOF SURVEY
UNDER

Application No. ~~G-8937~~ Permit No. G-8335..
IN NAME OF

...ROBERT JOHN LEMMENS.....

Surveyed ..JUN..25 1987., by B..S.....JAMES.....