


T.5S., R.1E., W.M.

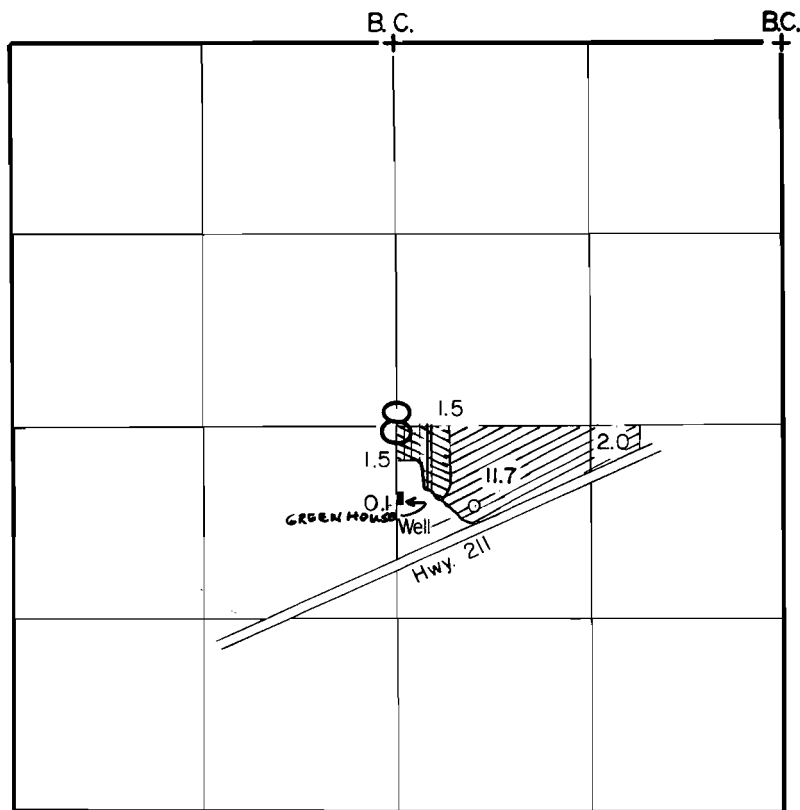

Well Loc. 550' S. & 540' E. from Center 1/4 Cor. Sec. 8.

 PRIMARY
  SUPPLEMENTAL
  CONTAINERIZED

Scale: 1" = 1320'

FINAL PROOF SURVEY

UNDER

Application No. G-8941. Permit No. G-9799.....

IN NAME OF

HAROLD M. MILLER

Surveyed JUNE 26, 1985., by T. Warren.....