


T. 4S., R. 1E., W.M.

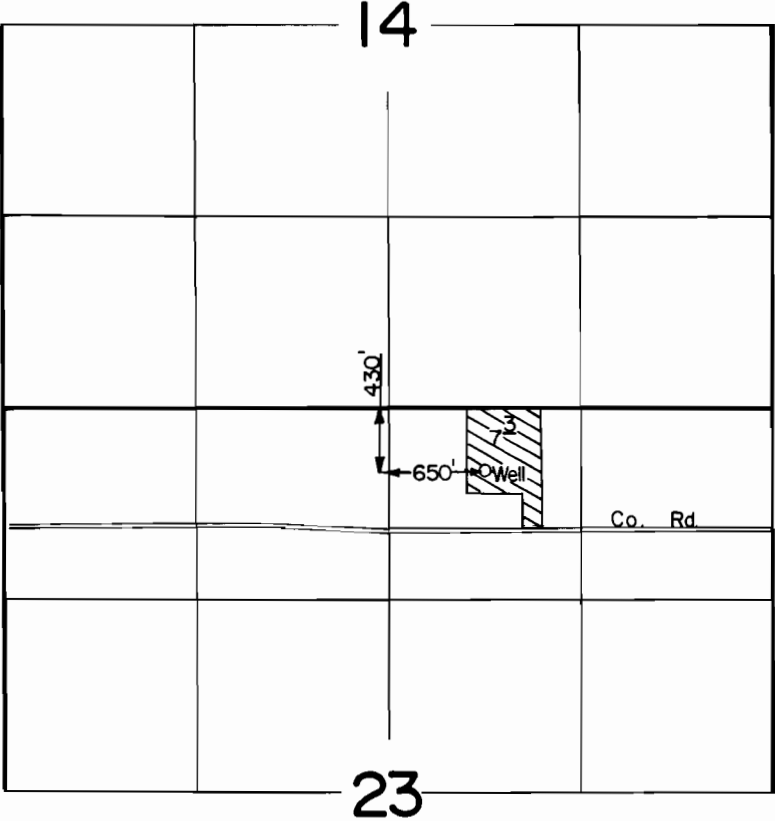

Scale: 1" = 1320'

FINAL PROOF SURVEY
UNDER

Application No. G-9391. Permit No. G-8641.....
IN NAME OF

GAIL & DEE CHRISTENSEN

Surveyed JULY...19. 1985., by ...I. Warren.....