


T.25S., R.18E., W.M.

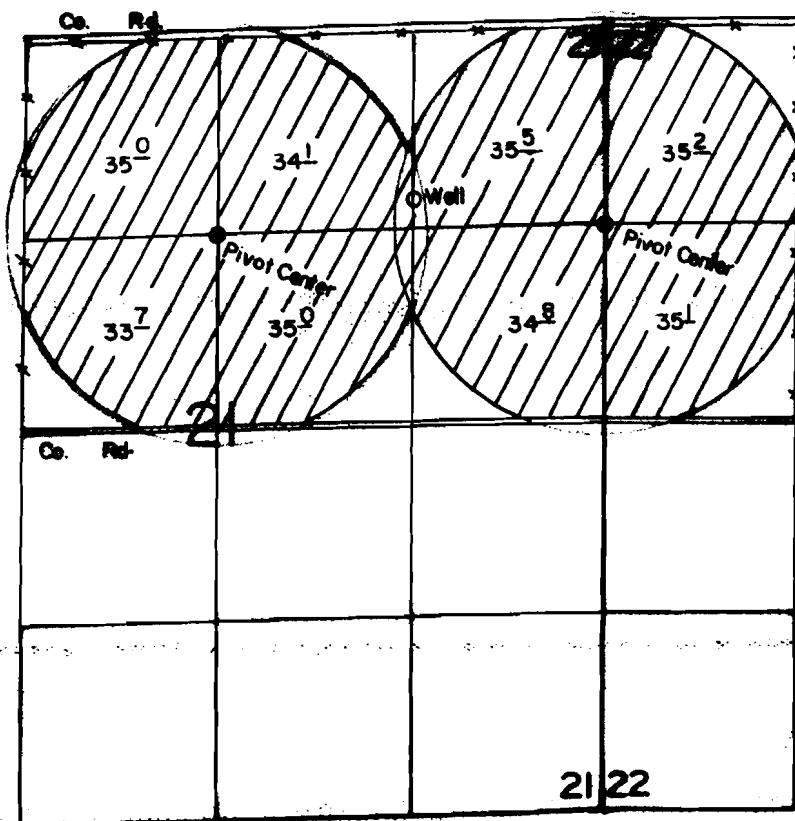

WELL LOCATED 1150' S. & 1350' W. FROM NE COR. SEC. 21

SCALE: 1"=1320'

FINAL PROOF SURVEY **UNDER**

Application No. G-9420. Permit No. G-8779.....
IN NAME OF

BIRCH CIRCLE FARMS INC.

Surveyed JULY 22, 1983, by L. TOL