


T. 4 S. R. 39 E. W. M.

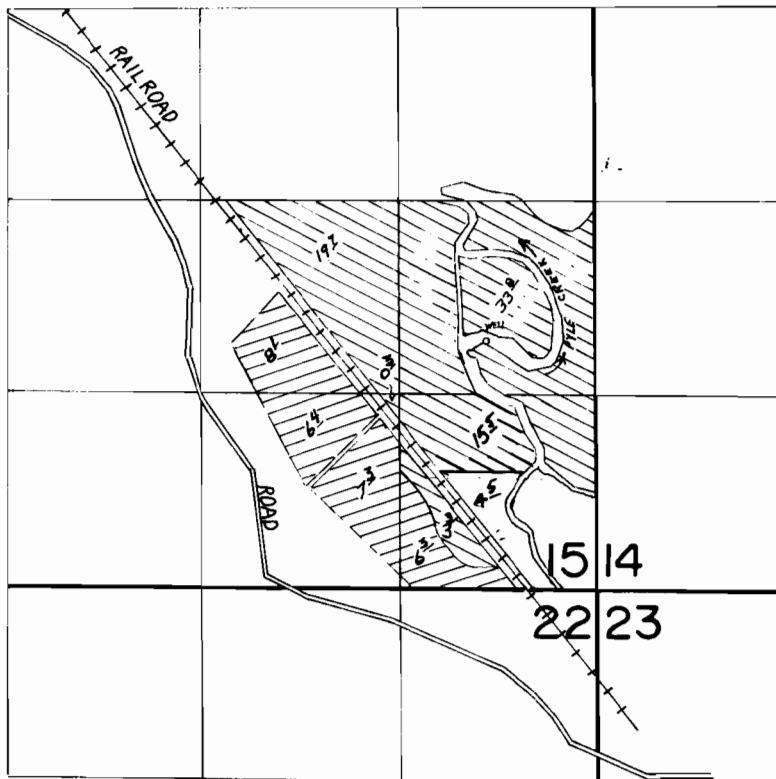

WELL LOCATED 1700' N. AND 750' W. FROM S.E. COR. SEC. 15



PRIMARY



SUPPLEMENTAL

## FINAL PROOF SURVEY

UNDER



SCALE: 1" = 1320'

Application No. G-9491 Permit No. G-8908  
IN NAME OF

JOHN A. CURTIS

Surveyed 7-10 1984, by V.L. CHURCH