


T. 1N., R. 2W., W.M.

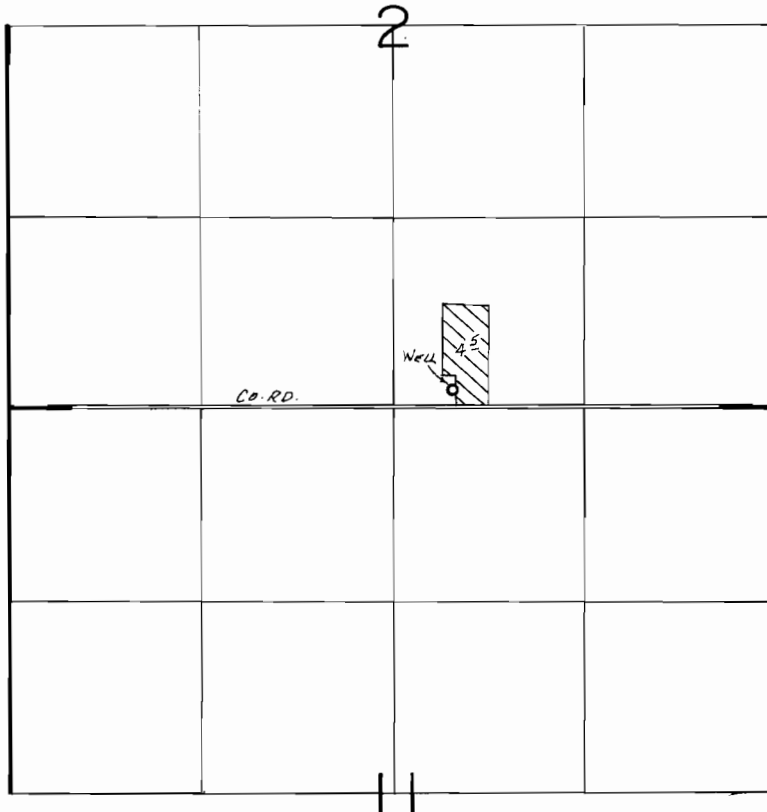

WELL LOC.: 110' N. & 120' E. FROM S 1/4 Co. RD. SEC. 2.

SCALE: 1" = 1320'

FINAL PROOF SURVEY UNDER

Application No. G-9498 Permit No. G-8895.....
IN NAME OF

.....ROBERT A. JOHNSON.....

Surveyed Sept. 2..... 19.86, by ..B.W. BISHOP....

1-28-87
BWB
41067-178-156B