


# T.6S. R.2W. W.M.

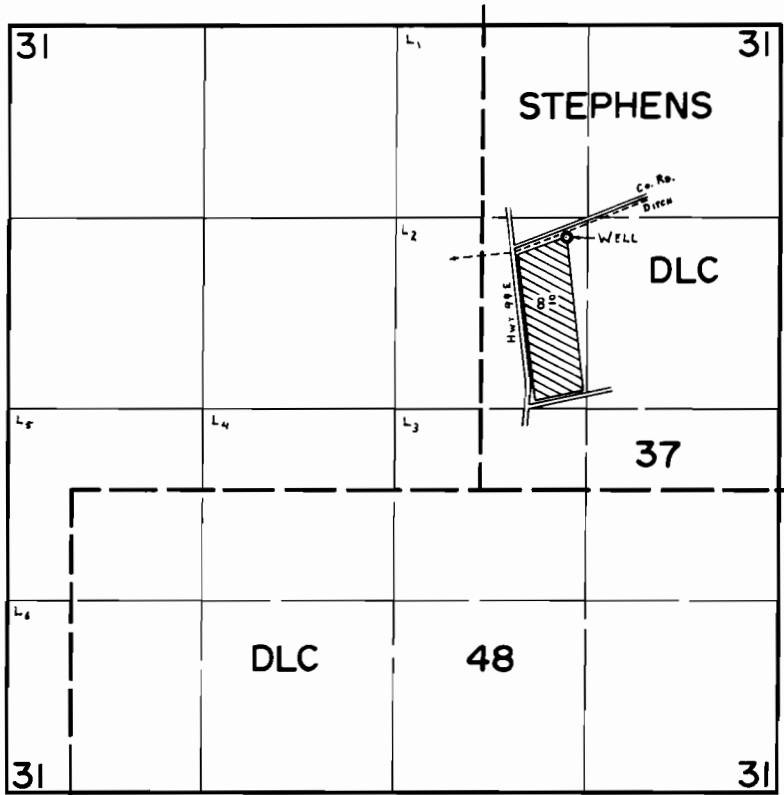

WELL Loc: 1730' N. & 575' E. fr S.W. Cor. STEPHENS DLC. 37.

## FINAL PROOF SURVEY UNDER

Application No. G-9506 Permit No. G-8754  
IN NAME OF

ERNEST L. WOOD

Surveyed June 26, 1980, by C. L. Hughes