


T. 35 S., R. 2 W., W. M.

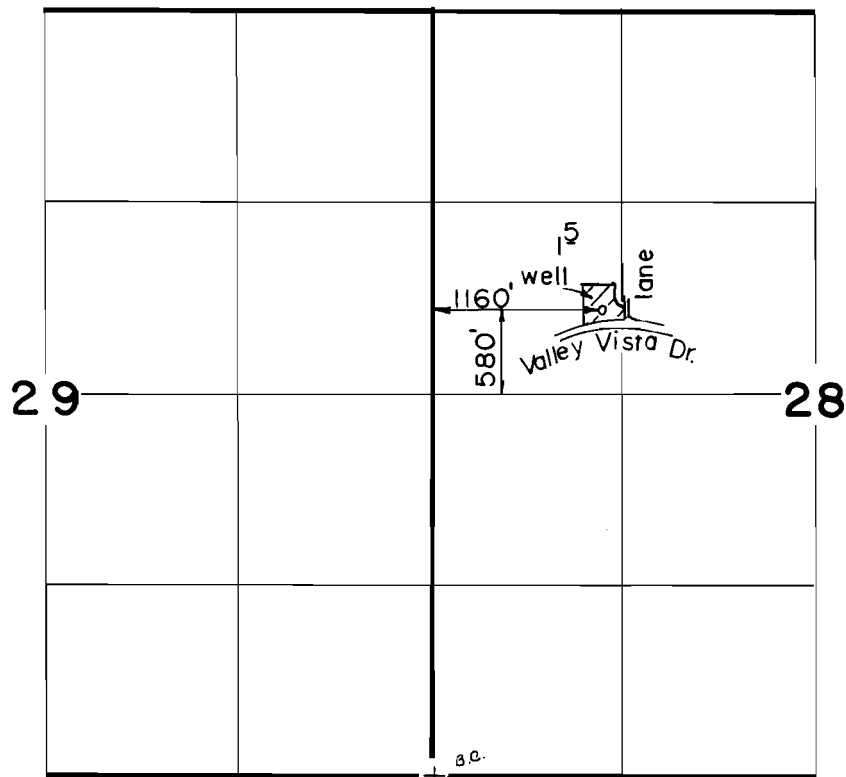

Scale: 1" = 1320'

FINAL PROOF SURVEY

UNDER

Application No. G-9586 Permit No. G-8992.
IN NAME OF

HOMER W. & RUTH J. SHERWOOD

Surveyed MAY 12, 1987, by B. S. JAMES