


T.13S., R.16E., W.M.

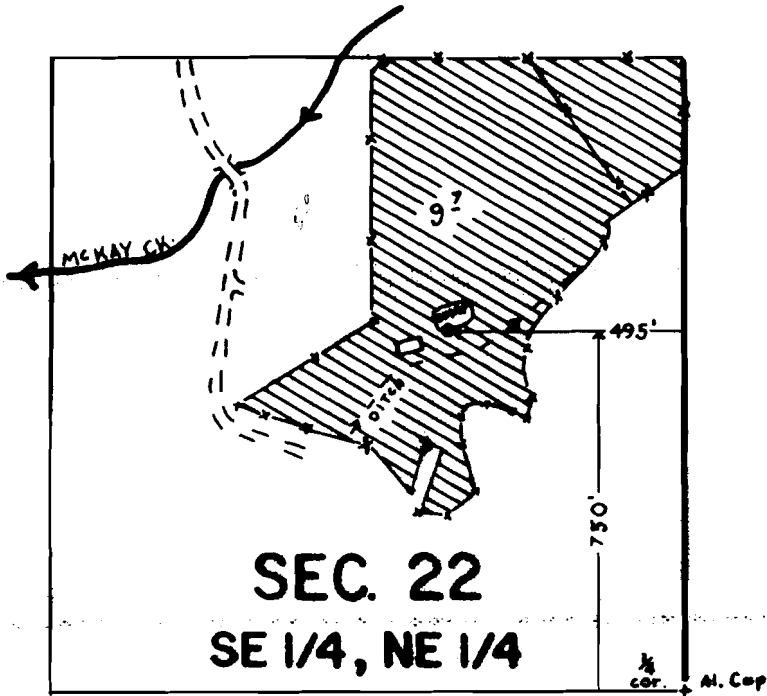

SCALE: 1" = 400'

FINAL PROOF SURVEY
UNDER

Application No. G-9605.. Permit No. G-8924.....
IN NAME OF

GERALD & JANIS MAGNUSON

Surveyed MARCH 20 1987..., by M.J. MATTICK.....

624 68
COPY # 22 96X

RECEIVED

DATE 12-7-89
WATER MASTER DISTRICT #19
BY BMJ