


T. 3S., R. 38E., W. M.

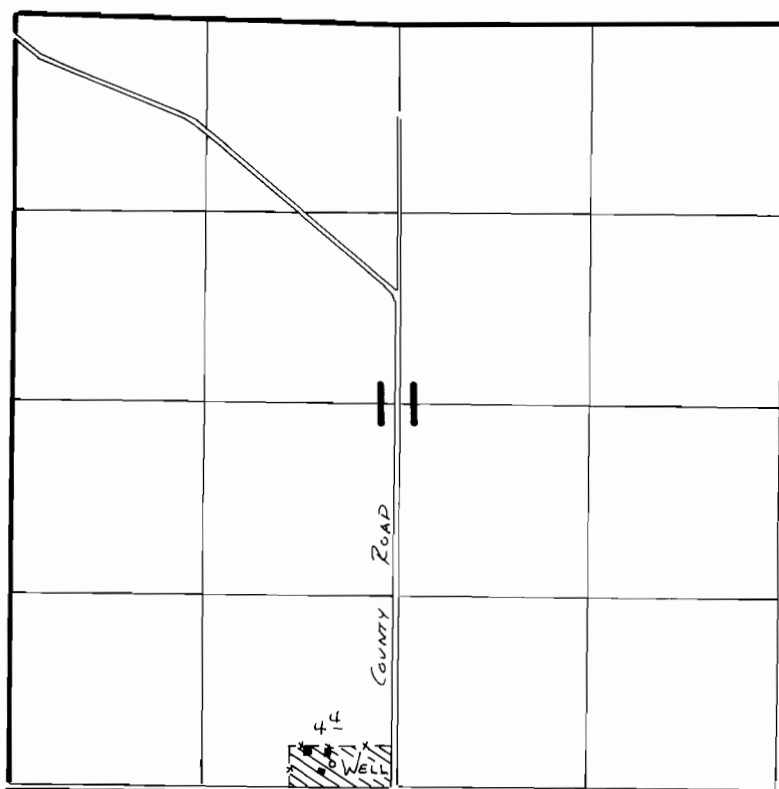

SCALE 1" = 1320'

WELL LOC: 170' N. & 420' W. FROM S 1/4 COR. SECTION 11

FINAL PROOF SURVEY UNDER

Application No. **G:9633** Permit No. **G:9054**
IN NAME OF

JAMES C. LUNDY

Surveyed **7-11-1984**, by **V. L. Church**