


T. 38 & 39 S., R. 19 E., W.

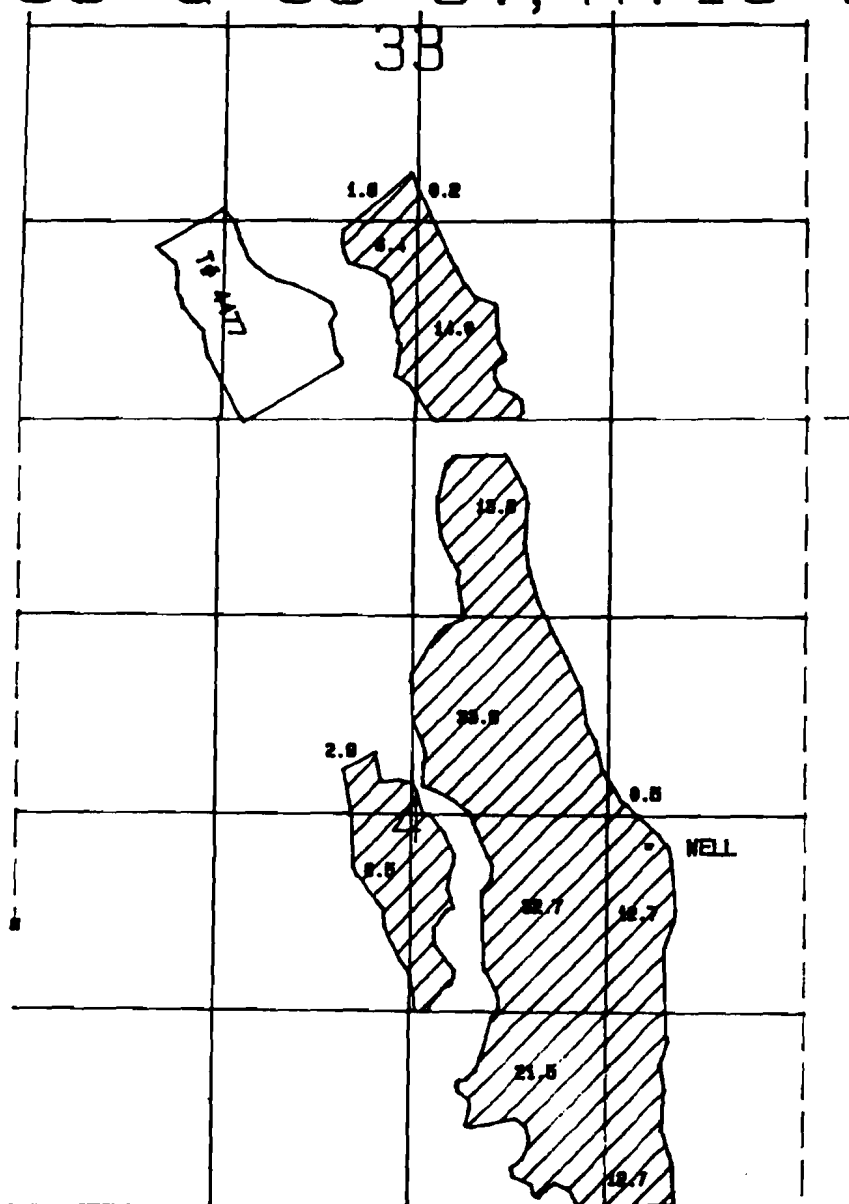

SCALE: 1" = 1320'

WELL LOCATED 2480 FT. N. AND 1070 FT. W. FROM SE COR. SEC. 4
FINAL PROOF SURVEY
UNDER

Application No. G-9683 Permit No. 6-8985

IN NAME OF

COTTONWOOD CATTLE COMPANY

Surveyed OCT. 16, 1987 BY M.J. MATTICK