


T. 5 & 6 S., R. 2 E., W.M.

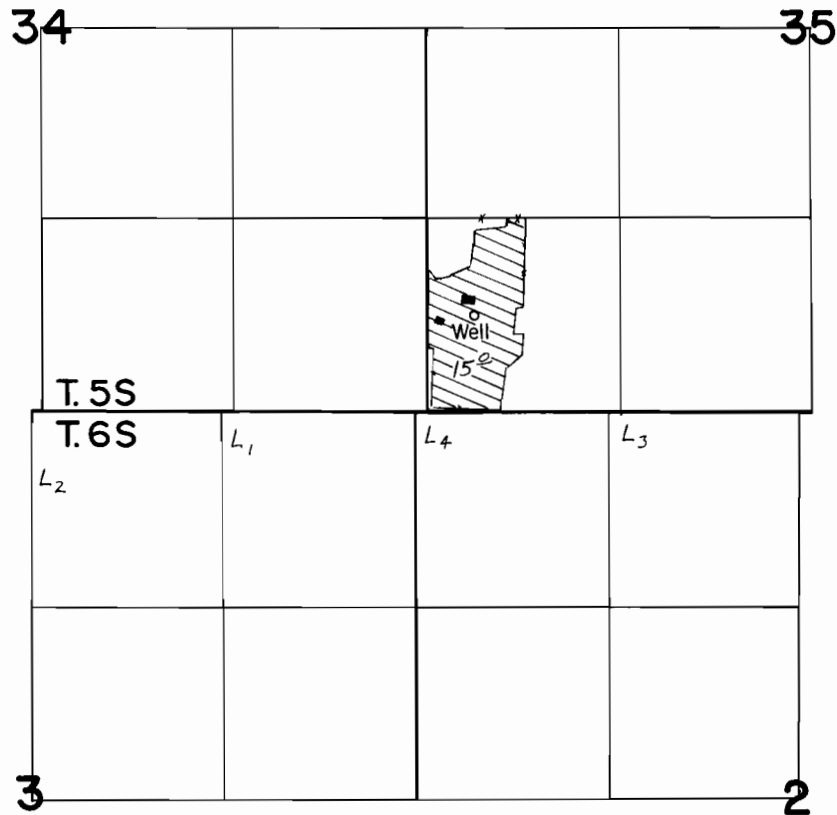

Well Loc. : 660' N. & 330' E. from SW Cor. Sec. 35.

Scale : 1" = 1320'

FINAL PROOF SURVEY UNDER

Application No. G-9733.. Permit No. G-9000....
IN NAME OF

RICHARD A. & CECELIA D. RUSSO

Surveyed JUNE 12, 1986, by J. Warren.....

PTS-1986-A
DFK-40-26
1/16/87 TMW