


T. 26S., R. 16E., W. M.

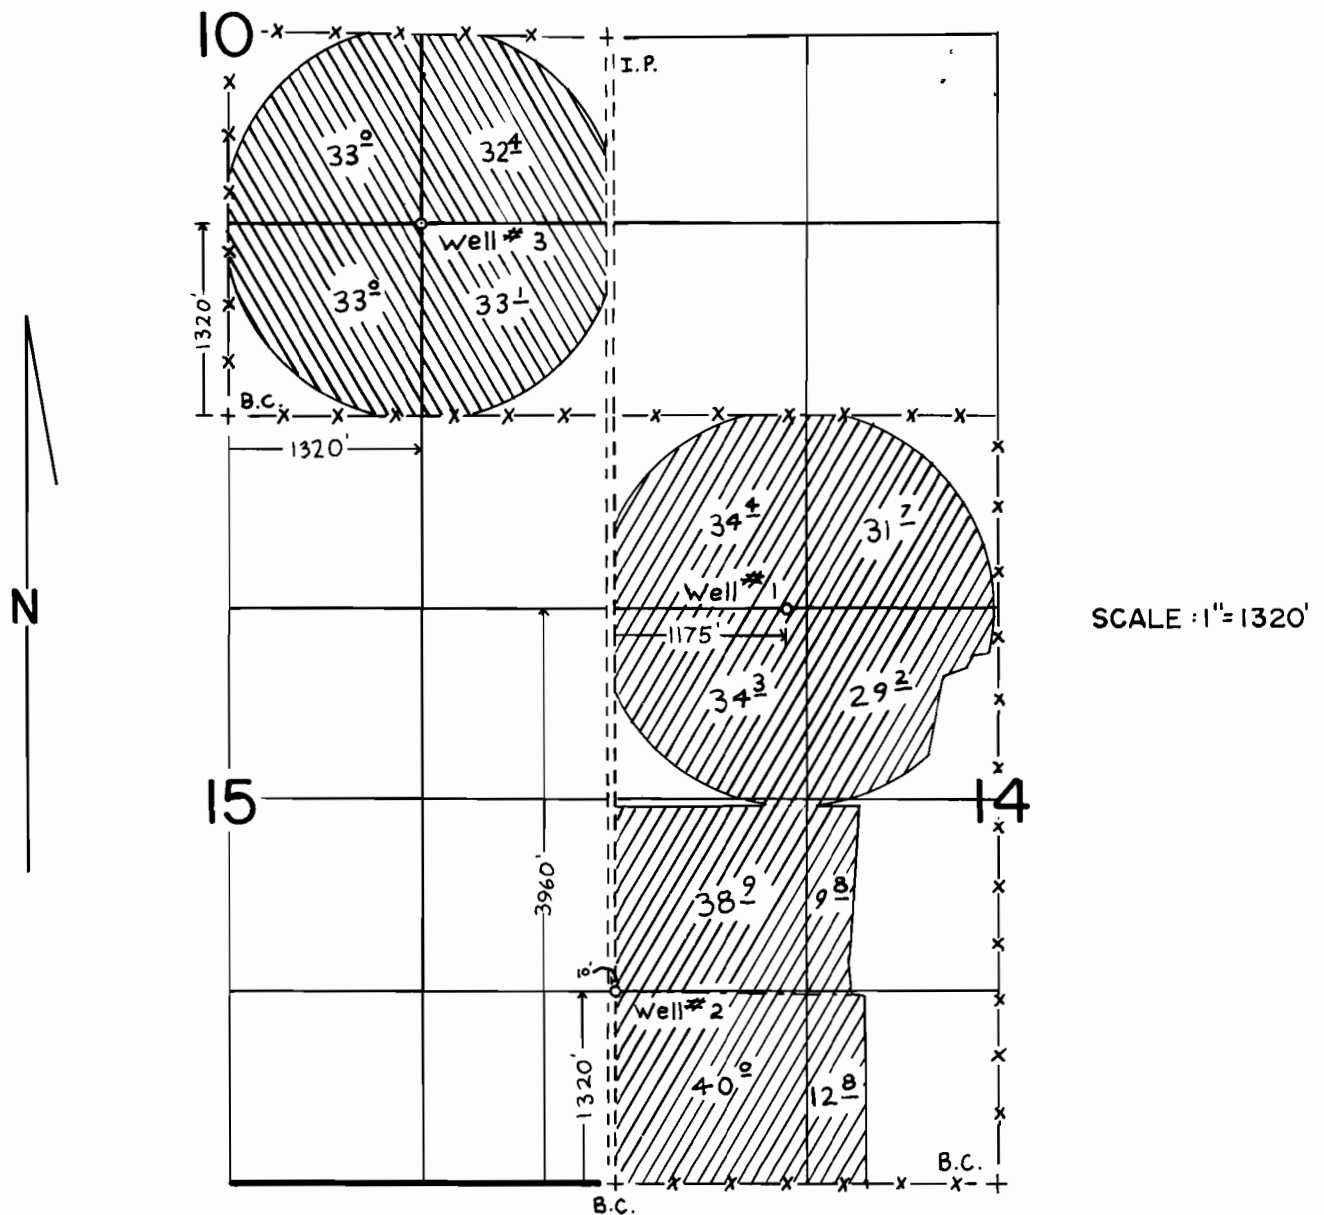

FINAL PROOF SURVEY

UNDER

G-9886

G-9141



Application No. G-10328. Permit No. G-9356.....



IN NAME OF

.....**MERVIN STUTZMAN**.....

Surveyed MAY. 14, 15, 1985., by LESLIE OLSON.....