


T. 35 S., R. 2 W., W. M.

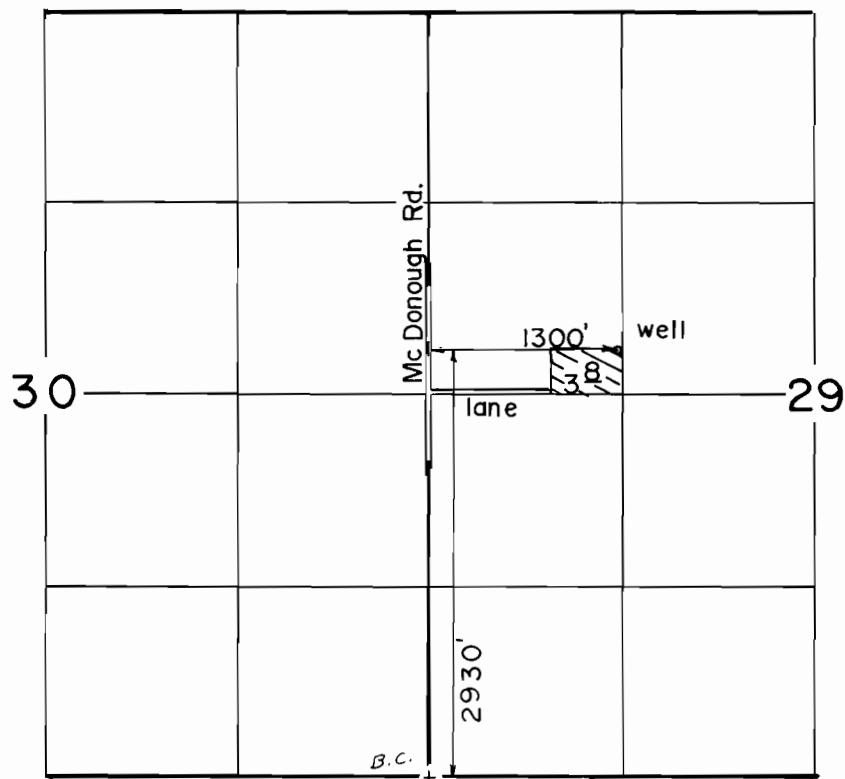

Scale: 1" = 1320'

FINAL PROOF SURVEY UNDER

Application No. G-9924 Permit No. G-9132..
IN NAME OF

KENNETH...M...&...VIRGINIA...R...WHITE

Surveyed MAY...13.. 19.8.7., by B...S...JAMES...