
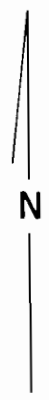


T. 35 S., R. 2 W., W. M.

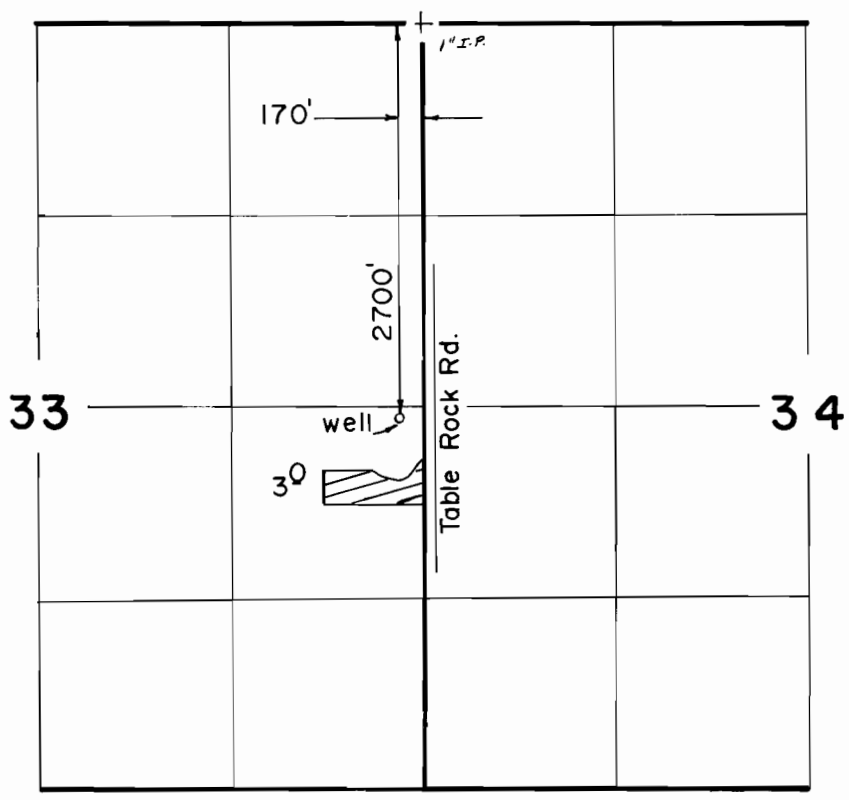

Scale: 1" = 1320'

FINAL PROOF SURVEY
UNDER

Application No. G-9930 Permit No. G-9133..
IN NAME OF

HENRY I. & /OR MARY E. PECH

Surveyed MAY 20, 1987, by B. S. JAMES