


T.14S., R.10E., W.M.

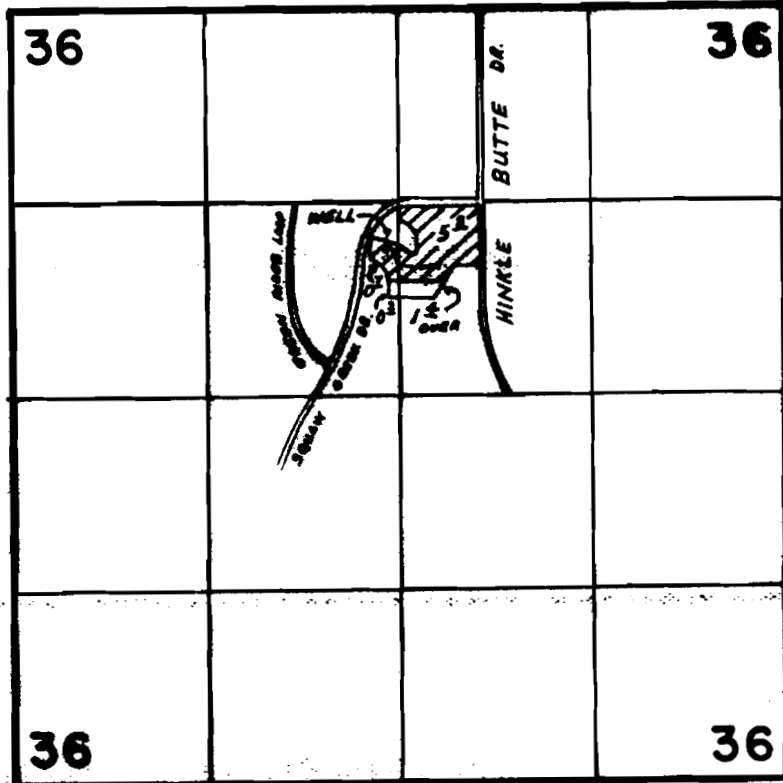

WELL LOG: 270'S & 650'W FROM N.E. COR. LOT 15, Block 6

SCALE: 1"=1320'

FINAL PROOF SURVEY
UNDER

Application No. G-9961 Permit No. G-9036
IN NAME OF

cert. # 62478

JOHN A. AND LAVINA D. SHIELDS

Surveyed OCT. 8, 1987, by M. J. MATTICK

RECEIVED

DATE 12-7-89

WATER MASTER DISTRICT #11

BY JMG