


G-9109
62480

T. 6 N., R. 34 E., W.M.

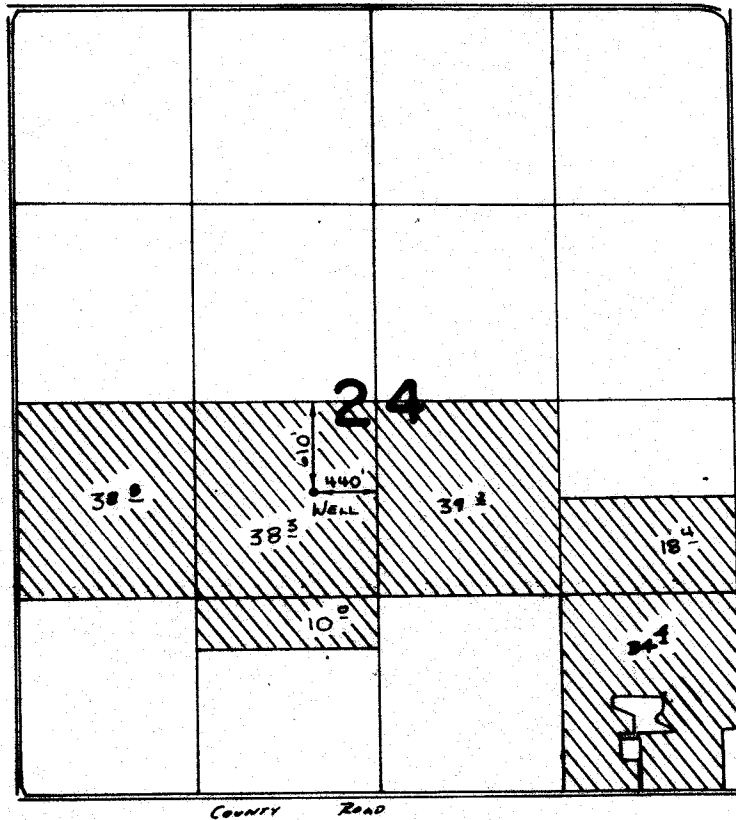

SCALE 4" = 1 MILE

FINAL PROOF SURVEY UNDER

Application No. G:9977 Permit No. G:9109...
IN NAME OF

JOE T. & LEHLA L. WEBSTER...

Surveyed 4-10..... 1984., by X. L. Church.....