


T. 23 S., R. 33 E., WM.

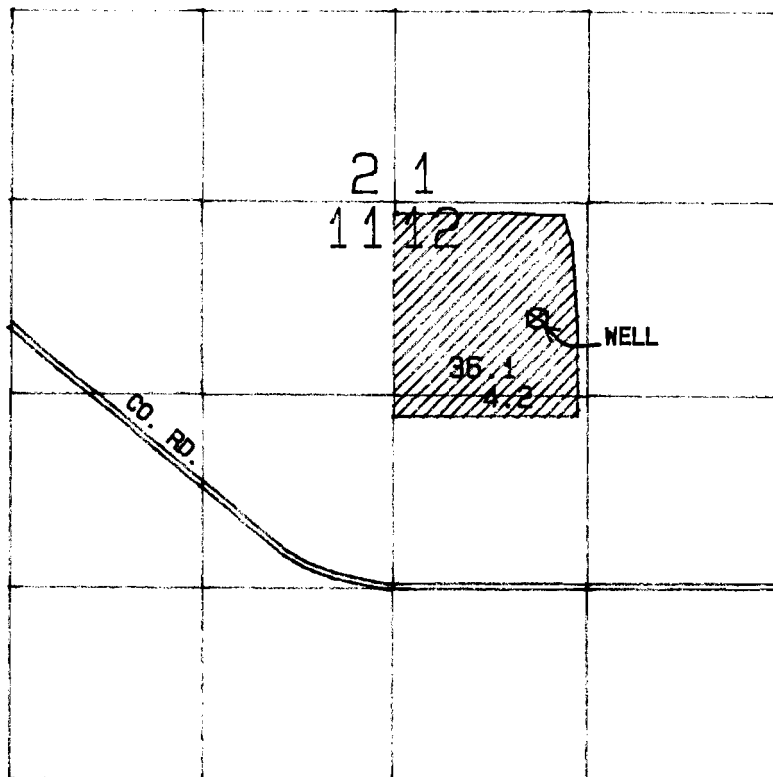

WELL LOCATED: 800 FT SOUTH AND 970 FT EAST FROM THE  
NORTHWEST CORNER OF SECTION 12

SCALE 1 IN = 1320 FT

FINAL PROOF SURVEY  
UNDER

APPLICATION NO.: 6-10047

PERMIT NO.: 6-9163

LYLE VICKERS

SURVEYED MAY 22, 1986 BY: LARRY TOLL

COMPUTER DRAFTED: TMW  
PHOTO 41025-179-36R  
PTS-1986 V-A