


# T.17S., R.3W. W.M.

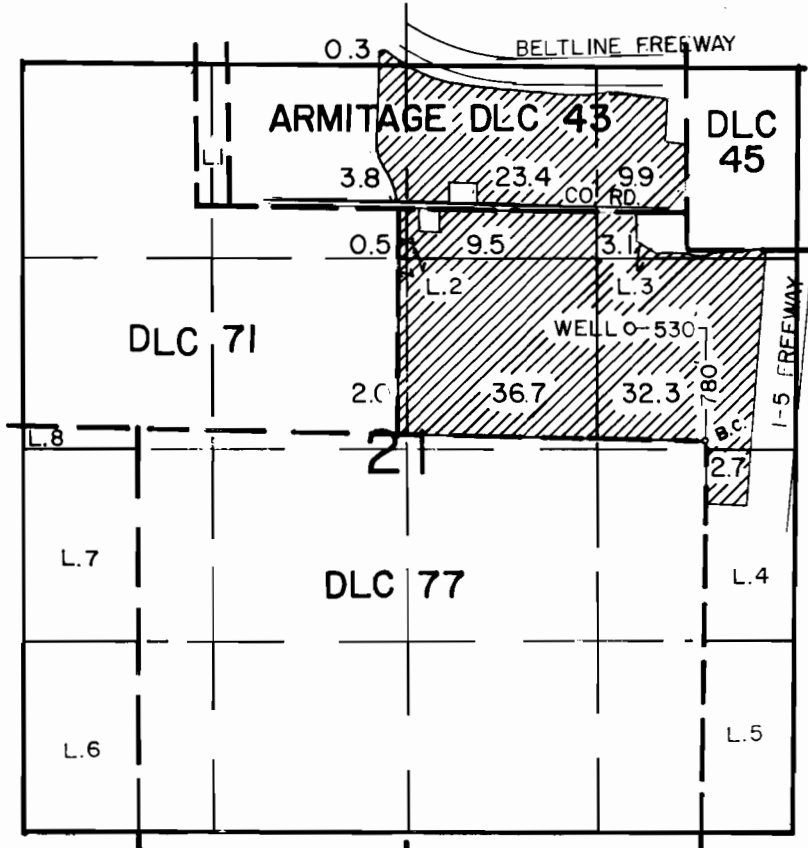

SCALE 1" = 1320'

## FINAL PROOF SURVEY UNDER

Application No. G:10050.. Permit No. G:9775.....  
IN NAME OF

**GERALD E. CALEF**

Surveyed MAY 23... 1985., by T.M. WARREN.....