


T. 22 & 23 S., R.32 1/2 E., WM.

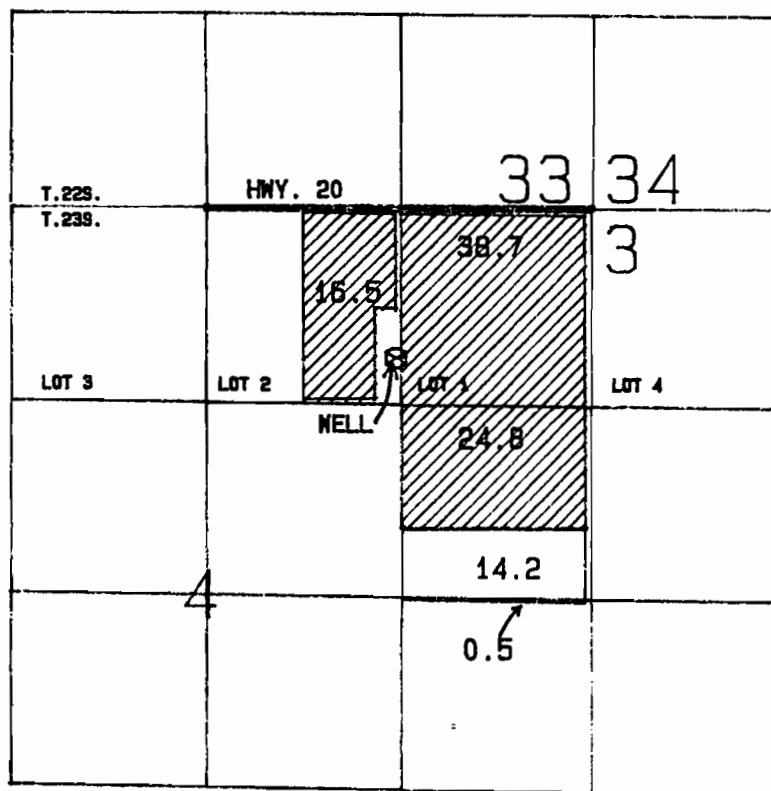

WELL LOCATED: 1010 FT SOUTH AND 1360 FT WEST FROM THE
NORTHEAST CORNER OF SECTION 4.

SCALE 1 IN = 1320 FT

FINAL PROOF SURVEY
UNDER

APPLICATION NO.: G-10087

PERMIT NO.: G-9199

LARRY & DONNA ROOT

SURVEYED JULY 16, 1986

BY: DON CLARK

COMPUTER DRAFTED: TMW
PHOTO 41025-179-32A