


62484

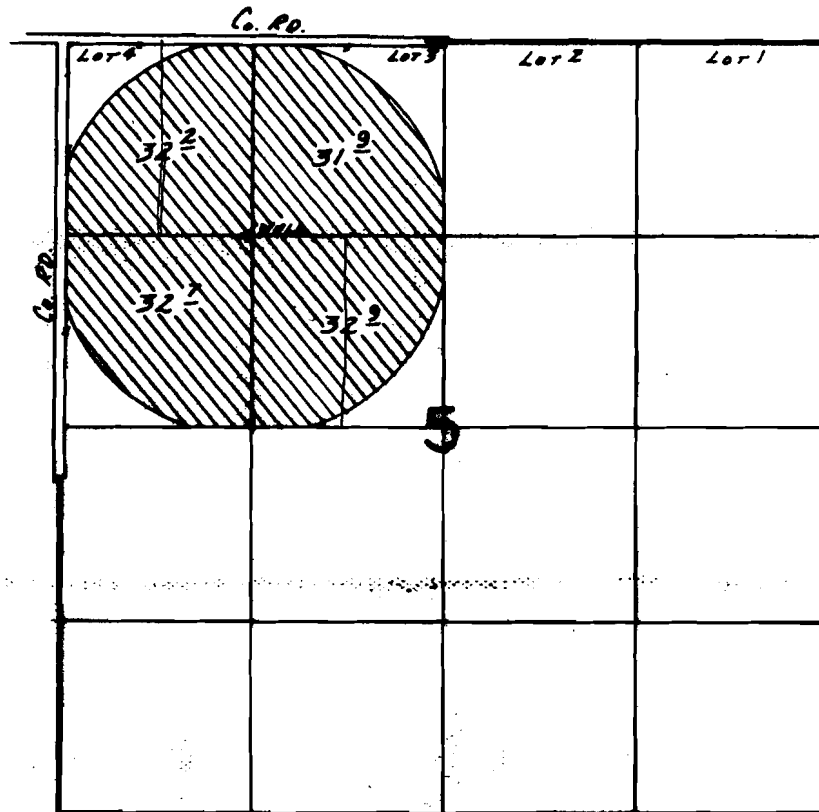

SCALE: 1"=1320'

FINAL PROOF SURVEY

UNDER

LESLIE L. SCHROCK

Surveyed Oct. 9..... 1985, by B.W.BISHOP.....