


T. 6S., R. 38E., W.M.

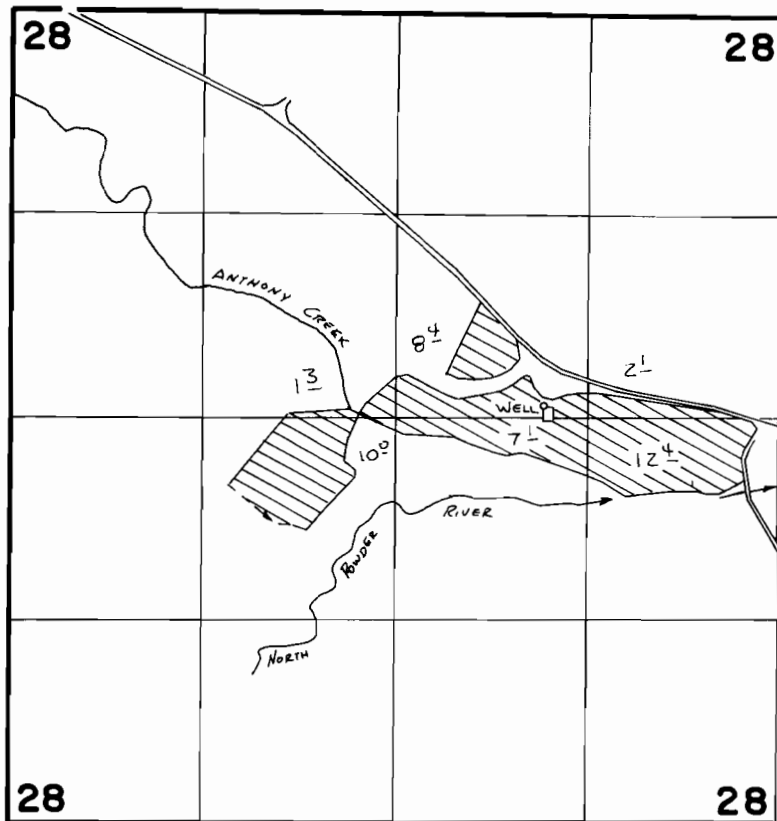

WELL LOC: 80'N. & 1020'E. FROM CENTER COR. SEC. 28

SCALE 1" = 1320'

FINAL PROOF SURVEY
UNDER

Application No. **G:10141** Permit No. **G:9226**
IN NAME OF

MICHAEL MASON

Surveyed **SEPT. 23** 19**82**, by **V. L. Church**