


G-9313
62488
T9648
T8816

T28S, R16E, W.M.

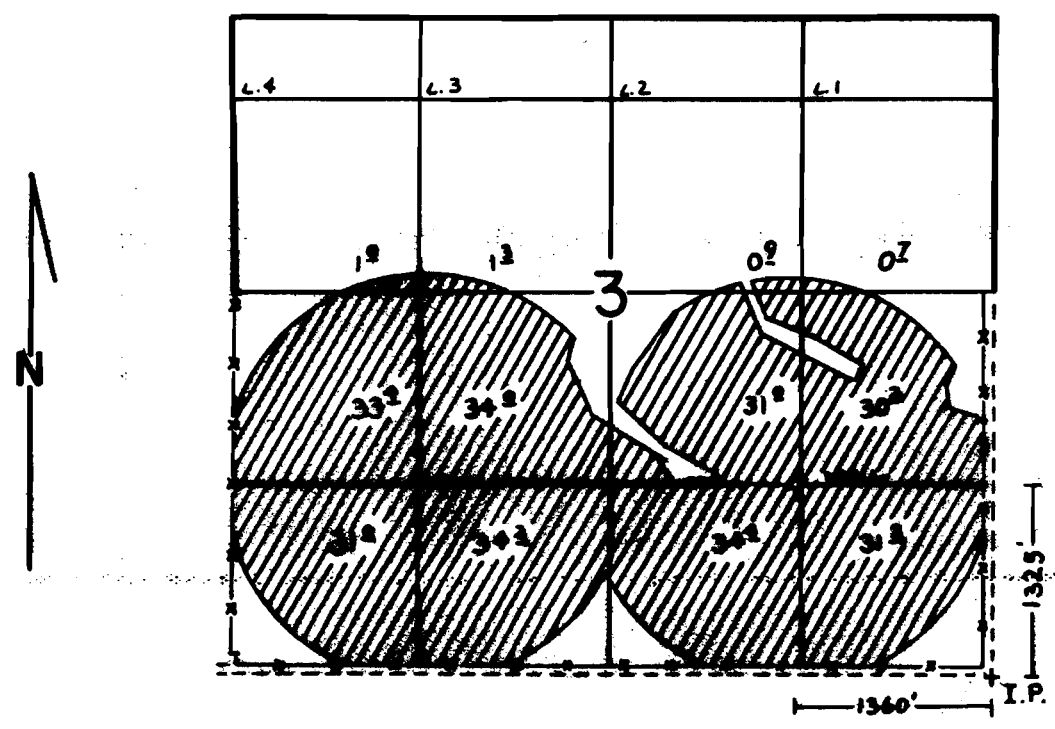

SCALE: 1" = 1320'

FINAL PROOF SURVEY UNDER

Application No. G-10200 Permit No. G-9313.....
IN NAME OF

~~KENNETH & PATRICIA GREENE~~

J.R. Vloedman
DVA

Surveyed SEPT. 26 1985., by LESLIE OLSON....