




T. 2 S., R. 1 E., W.M.

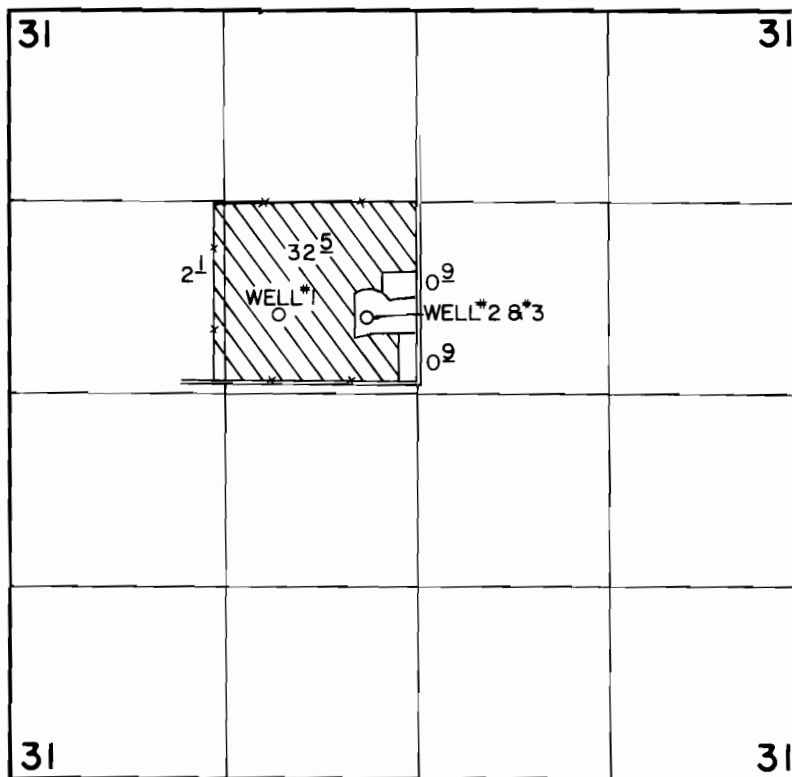

WELL*1 LOC: 550' N. & 1850' E. FROM W/4 CORNER SECTION 31

SCALE: 1" = 1320'

FINAL PROOF SURVEY
UNDER

Application No. G-10220 Permit No. G-9281.....
IN NAME OF

..... HARVEY A. OLDENSTADT

Surveyed SEPT. 5, 1986, by T. WARREN.....