


T. 15., R. 13E., W.M.

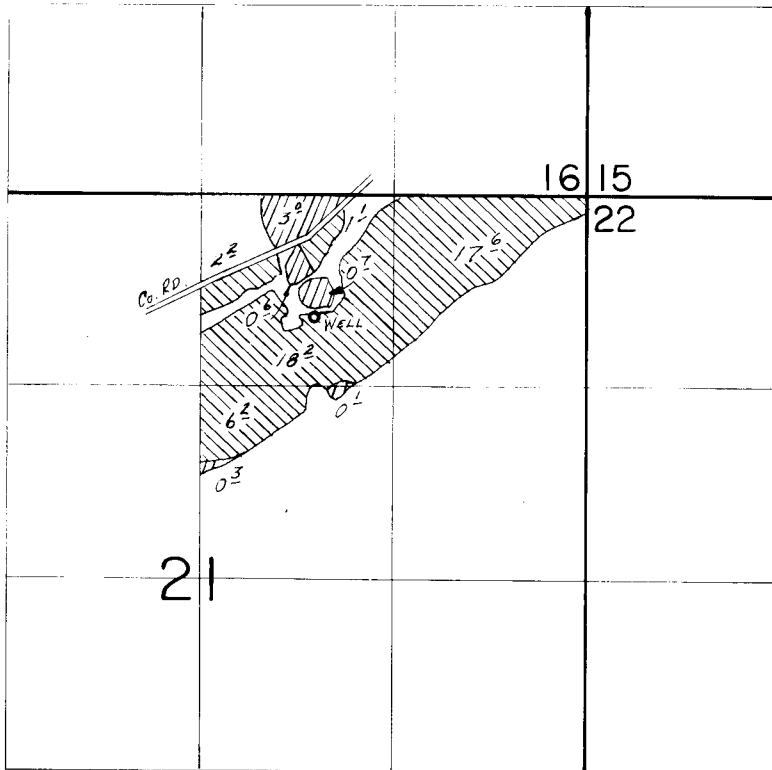

WELL Loc.: 850 S. & 1870 W. FROM NE COR. SEC. 21.

 PRIMARY
 SUPPLEMENTAL SCALE: 1"=1320'

FINAL PROOF SURVEY UNDER

Application No. G:10287. Permit No. G:9372...
IN NAME OF

MONTE B. & JANET WASSON.....

Surveyed Aug. 13... 1987., by V.L. CHURCH.....