


T.18&2S.,R.2W.,W.M.

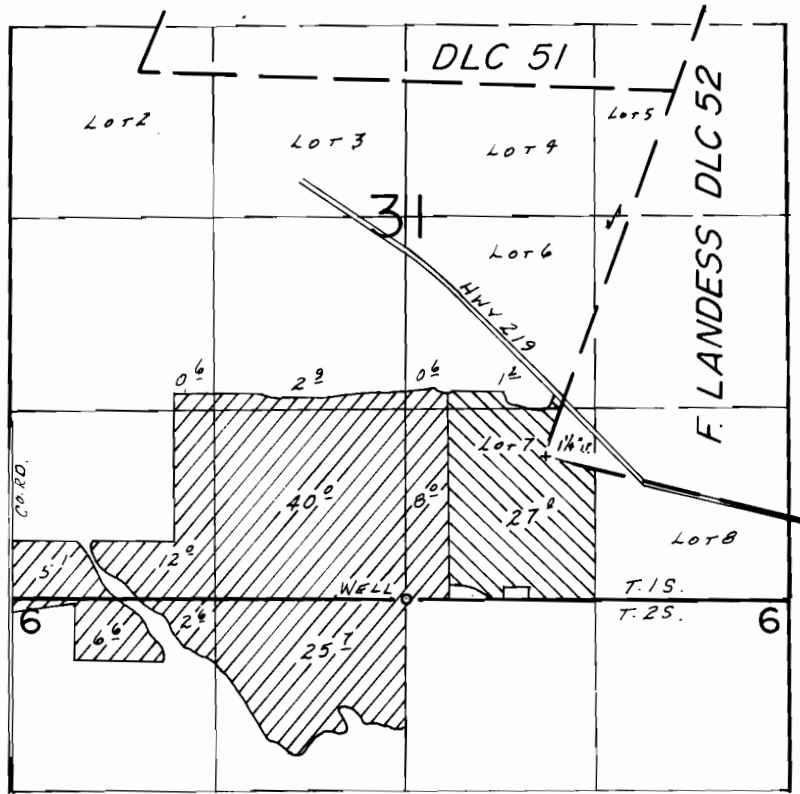

WELL LOC: 980'S. & 980'W. FROM SW. COR. F. LANDESS DLC 52.

SCALE: 1"=1320'

FINAL PROOF SURVEY UNDER

G-10319 G-9369 
 Application No. G-10320 Permit No. G-9370 

IN NAME OF

ROY J. MALENSKY

Surveyed July 23, 1986, by B.W. BISHOP

2-3-87 *bab*