


# T.3&4S., R.1E. W.M.

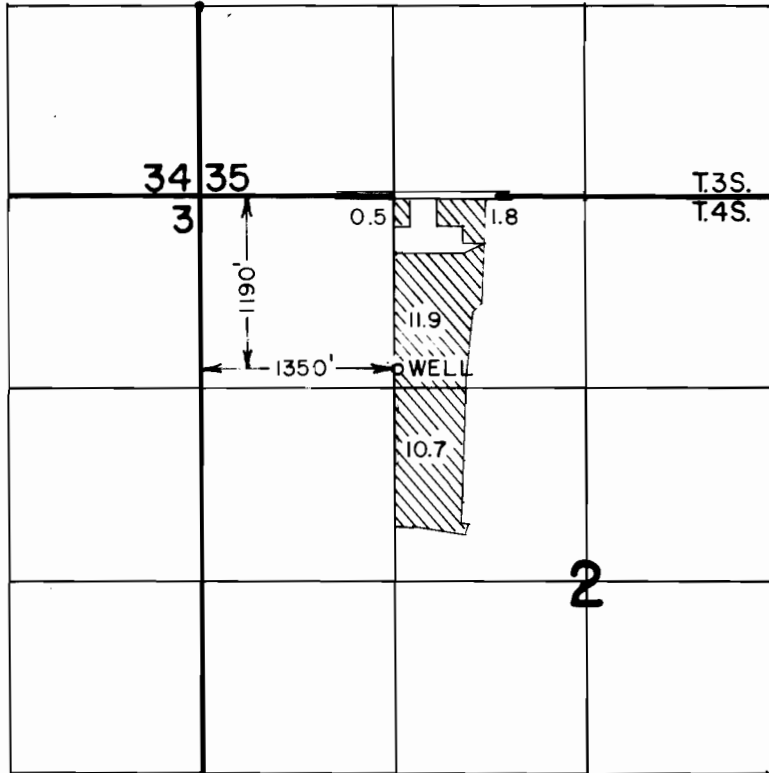

## FINAL PROOF SURVEY UNDER


Application No. G-10362 Permit No. G-9576  
IN NAME OF

CRAIG ZIELINSKI

Surveyed JUNE 30 1986, by T. WARREN



# T. 3 & 4 S., R. 1 E., W.M.

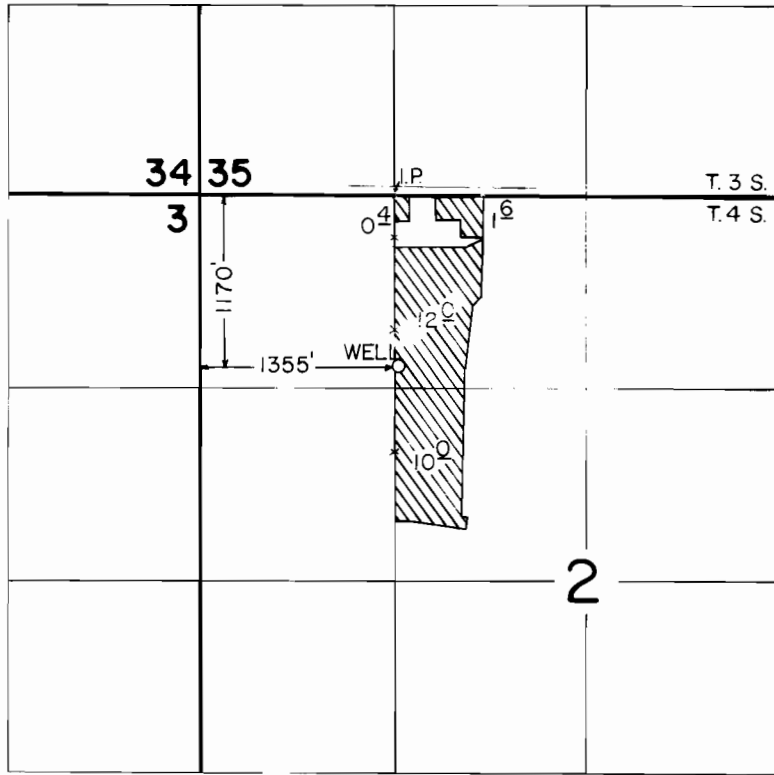

SCALE: 1" = 1320'

## FINAL PROOF SURVEY UNDER

Application No. G-10362 Permit No. G-9576  
IN NAME OF

CRAIG ZIELINSKI

Surveyed JUNE 30 1986, by T. WARREN